


WELL PLUGGING RECORD

Give All Information Completely
Make Required Affidavit
Mail or Deliver Report to:
Conservation Division
State Corporation Commission
800 Bittling Building
Wichita, Kansas

NORTH

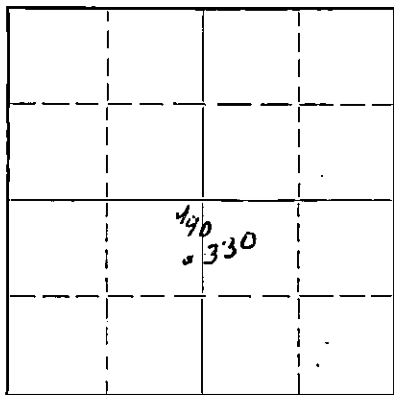

Locate well correctly on above
Section Plat

Stafford County, Sec. 18 Twp. 21 Rge. 12 (E) (W)
Location as "NE/CNW/4SW/4" or footage from lines
Lease Owner Campbell & Dachs
Lease Name Welsch 13 Well No. 2
Office Address 1415 Jackson Street Bend Lane
Character of Well (completed as Oil, Gas or Dry Hole) Dry hole
Date well completed Dec 1951 19.53
Application for plugging filed 4 months 19.53
Application for plugging approved 4-13 19.53
Plugging commenced 4-27 19.53
Plugging completed 5-3 19.53
Reason for abandonment of well or producing formation Dry hole

If a producing well is abandoned, date of last production 19.
Was permission obtained from the Conservation Division or its agents before plugging was commenced? yes

Name of Conservation Agent who supervised plugging of this well Merle Pines
Producing formation _____ Depth to top _____ Bottom _____ Total Depth of Well 3616 Feet
Show depth and thickness of all water, oil and gas formations.

OIL, GAS OR WATER RECORDS

CASING RECORD

Formation	Content	From	To	Size	Put In	Pulled Out
				8 5/8	250	none
				5 5/8	3609	2682'

Describe in detail the manner in which the well was plugged, indicating where the mud fluid was placed and the method or methods used in introducing it into the hole. If cement or other plugs were used, state the character of same and depth placed, from _____ feet to _____ feet for each plug set.

Plugged with crushed rock from 3616' to 3600' fine ray cement at 3600' filled 3565' filled with mud to 250' set rock bridge 20 ray cement filled 190' filled with mud to 35' set rock bridge dumped 10 ray cement for cap.

RECEIVED
STATE CORPORATION COMMISSION
MAY 13 1953
CONSERVATION DIVISION
Wichita, Kansas
5-13-53

(If additional description is necessary, use BACK of this sheet)
Correspondence regarding this well should be addressed to Campbell 1415 Jackson St -
Address Bend Lane

STATE OF Kansas, COUNTY OF Stafford, ss. _____
(employee of owner) or (owner or operator) of the above-described well,
being first duly sworn on oath, says: That I have knowledge of the facts, statements, and matters herein contained and the log of the above-described well as filed and that the same are true and correct. So help me God.

(Signature) Campbell
(Address)

SUBSCRIBED AND SWORN to before me this 12 day of May, 1953
Martha M. Geit
Notary Public.

My commission expires Sept. 19, 1954
22-7377-s 4-49-10M

PLUGGING
FILE SEC 18 T 21 R 12 W
BOOK PAGE 92 LINE 10

WELL LOG BUREAU--KANSAS GEOLOGICAL SOCIETY

503 East Murdock,

Wichita, Kansas


15.185.11495.0000

Company- CAMPBELL & KUHN
Farm- Welsh "B" No. 2

SEC. 18 T. 21 R. 12W
SE NE SW

Total Depth. 3636
Comm. 3-17-51 Comp. 1-14-52
Shot or Treated.
Contractor. Campbell Drilling Co.
Issued. 4-26-52

County Stafford
KANSAS

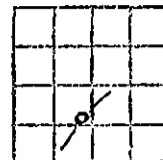

CASING:

8" 276'
5 1/2" 3610'

Elevation. _____

Production. dry

Figures Indicate Bottom of Formations.

sand, cly	185
red bed., shells	267
redbed, shale, shells	690
red bed	720
anhydrite	745
shale, shells	1160
shale, shale	1265
shale, shells	1445
lime, shale	1755
lime sdy	1885
lime	2280
lime, shale	2610
shale	2755
lime, shale	3070
lime broken	3110
lime, shale	3205
shale	3297
lime, shale	3403
lime	3510
conglomerate	3545
chert, shale, lime	3584
simpson	3610
arbuckle	3616
T.D. Rotary --- No Oil	
Cable Tools T.D.	3636

Drilled new hole from 3616-2627
lime grey hard 3616-3623
lime grey & green shale
Rainbow of oil 3627
Hole Full of Water 3636
Total Depth

Tops: Scout.
Brown Lime 3261
Lansing 3278
Cherty Conglomerate 3521
Viola Ch. 3532
Simpson shale 3559
Arbuckle 3609

PLUGGING
FILE SEC 18 T 21 R 12W
BOOK PAGE 92 LINE 10

RECEIVED
STATE COMMISSION
MAY 14 1953
CONSERVATION DIVISION
Wichita, Kansas