


Give All Information Completely
Make Required Affidavit
Mail or Deliver Report to:
Conservation Division
State Corporation Commission
211 No. Broadway
Wichita, Kansas

WELL PLUGGING RECORD

Stafford County, Sec. 18 Twp. 21S Rge. 12W (E) (W)
Location as "NE/CNW%SW%" or footage from lines C NE
Lease Owner Herman Geo. Kaiser, Oil Producer
Lease Name Christiansen Well No. 1
Office Address 909 Palace Bldg., Tulsa 3, Okla. 74103
Character of Well (completed as Oil, Gas or Dry Hole) Dry Hole
Date well completed 4-24-65 19
Application for plugging filed 4-24-65 19
Application for plugging approved 4-24-65 19
Plugging commenced 4-24-65 19
Plugging completed 4-24-65 19
Reason for abandonment of well or producing formation Dry Hole

NORTH

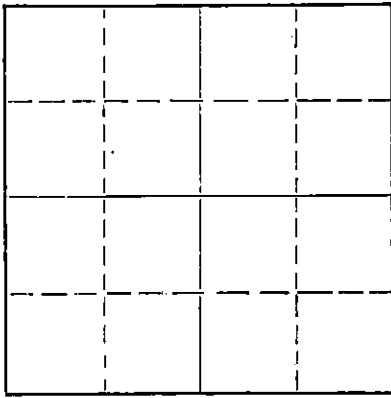

Locate well correctly on above
Section Plat

If a producing well is abandoned, date of last production 19
Was permission obtained from the Conservation Division or its agents before plugging was commenced? yes

Name of Conservation Agent who supervised plugging of this well Donald Truan for Archie Elving, Pratt, Ks.
Producing formation _____ Depth to top _____ Bottom _____ Total Depth of Well 3604 Feet
Show depth and thickness of all water, oil and gas formations.

OIL, GAS OR WATER RECORDS

CASING RECORD

FORMATION	CONTENT	FROM	TO	SIZE	PUT IN	PULLED OUT
				8 5/8"	274'	none

Describe in detail the manner in which the well was plugged, indicating where the mud fluid was placed and the method or methods used in introducing it into the hole. If cement or other plugs were used, state the character of same and depth placed, from _____ feet to _____ feet for each plug set.

Mud to 265' Plug 1/2 sk. hulls 25 sks. cement through drill pipe
Mud to 40' Plug 1/2 sk. hulls 10 sks. cement 2 sks. in rathole

RECEIVED
STATE CORPORATION COMMISSION

APR 29 1965

4-29-65

CONSERVATION DIVISION
Wichita, Kansas

(If additional description is necessary, use BACK of this sheet)

Name of Plugging Contractor Leben Drilling, Inc.
Address Box 486, Great Bend, Kansas

STATE OF KANSAS, COUNTY OF BARTON, ss.

Leslie Kite (employee of owner) or (owner or operator) of the above-described well, being first duly sworn on oath, says: That I have knowledge of the facts, statements, and matters herein contained and the log of the above-described well as filed and that the same are true and correct. So help me God.

(Signature)

Leslie Kite

P. O. Box 486, Great Bend, Kansas
(Address)

SUBSCRIBED AND SWORN TO before me this 28th day of April, 1965

Wanda Nichols

Notary Public.

My commission expires April 1, 1967

DRILLER'S LOG

COMPANY: Herman Geo. Kaiser, Oil Producer
 CONTRACTOR: LEBEN DRILLING, INC.
 FARM: CHRISTIANSEN C-#1
 LOCATION: C NE Sec. 18-21S-12W
 STAFFORD COUNTY, KANSAS
 COMMENCED: 4-17-65
 COMPLETED: 4-24-65

0	70	Sand
70	210	Sand & Gravel
210	273	Shale & Redbed
273	691	Redbed
691	715	Anhydrite
715	745	Shale & Shells
745	1675	Shale
1675	2020	Lime & Shale
2020	2370	Shale & Lime
2370	2855	Shale
2855	3245	Lime & Shale
3245	3604	Lime
	<u>3604</u>	<u>RTD - D & A</u>

RECEIVED
 STATE CORPORATION COMMISSION
 APR 29 1965
 CONSERVATION DIVISION
 Wichita, Kansas

Set 8 5/8" used surface casing @ 274' cemented with 250 sacks GL3

I, Leslie Kite, do hereby certify that the above and foregoing is a true and correct copy of the log of the Christiansen C-#1 well, located C NE of Section 18, Township 21 South, Range 12 West, Stafford County, Kansas, as reflected by the files of Leben Drilling, Inc.

Leslie Kite
 Leslie Kite

STATE OF KANSAS)
) SS
 COUNTY OF BARTON)

Subscribed and sworn to before me, a Notary Public, in and for Barton County, Kansas, this 28th day of April, 1965.

Ulanda Nichols
 Ulanda Nichols

My Commission Expires:
 April 1, 1967