

Give All Information Completely
Make Required Affidavit
Mail or Deliver Report to:
Conservation Division
State Corporation Commission
211 No. Broadway
Wichita, Kansas

WELL PLUGGING RECORD

Stafford County. Sec. 18 Twp. 21S Rge. 12W (E) (W)

Location as "NE/CNW/SW" or footage from lines. E 1/2 E 1/2 NW

Lease Owner: Herman Geo. Kaiser, Oil Producer

Lease Name: Christiansen Well No. B-#1

Office Address: 909 Palace Bldg., Tulsa 3, Okla. 74103

Character of Well (completed as Oil, Gas or Dry Hole) Dry Hole

Date well completed 6-7-65 19

Application for plugging filed 6-7-65 19

Application for plugging approved 6-7-65 19


Plugging commenced 6-7-65 19

Plugging completed 6-7-65 19

Reason for abandonment of well or producing formation Dry Hole

If a producing well is abandoned, date of last production 19

Was permission obtained from the Conservation Division or its agents before plugging was commenced? yes

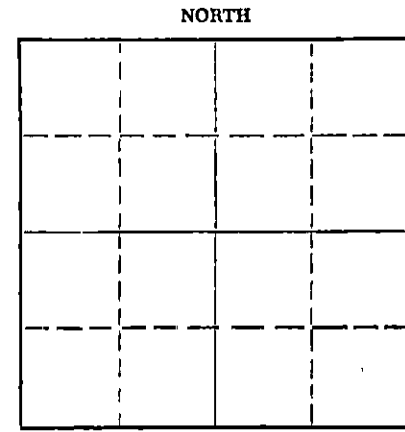

Locate well correctly on above Section Plat

Name of Conservation Agent who supervised plugging of this well Archie Elving, Pratt, Kansas

Producing formation _____ Depth to top _____ Bottom _____ Total Depth of Well 3580 Feet

Show depth and thickness of all water, oil and gas formations.

OIL, GAS OR WATER RECORDS

CASING RECORD

FORMATION	CONTENT	FROM	TO	SIZE	PUT IN	PULLED OUT
				8 5/8"	270'	none

Describe in detail the manner in which the well was plugged, indicating where the mud fluid was placed and the method or methods used in introducing it into the hole. If cement or other plugs were used, state the character of same and depth placed, from _____ feet to _____ feet for each plug set.

Push Plug to 260' 3/4 sk. hulls 25 sks. cement through drill pipe
Mud to 40' 1/2 sk. hulls 10 sks. cement

RECEIVED
STATE CORPORATION COMMISSION
6-10-65 JUN 10 1965
CONSERVATION DIV.
Wichita, Kansas

(If additional description is necessary, use BACK of this sheet)

Name of Plugging Contractor: Leben Drilling, Inc.

Address: Box 486, Great Bend, Kansas 67530

STATE OF KANSAS, COUNTY OF BARTON, ss.
Leslie Kite (employee of owner) or (owner or operator) of the above-described

well, being first duly sworn on oath, says: That I have knowledge of the facts, statements, and matters herein contained and the log of the above-described well as filed and that the same are true and correct. So help me God.

(Signature) Leslie Kite

P. O. Box 486, Great Bend, Kansas (Address)

SUBSCRIBED AND SWORN TO before me this 9th day of June, 1965

My commission expires April 1, 1967

Wanda [Signature] Notary Public.

DRILLER'S LOG

COMPANY: Herman George Kaiser
 Oil Producer
 CONTRACTOR: LEBEN DRILLING, INC.
 FARM: CHRISTIANSEN B-#1
 LOCATION: E $\frac{1}{2}$ E $\frac{1}{2}$ NW Sec. 18-21S-12W
 STAFFORD COUNTY, KANSAS
 COMMENCED: 6-1-65
 COMPLETED: 6-7-65

0	40	Sand
40	125	Sand & Gravel
125	270	Shale & Redbed
270	700	Redbed
700	720	Anhydrite
720	1050	Redbed & Shale
1050	1570	Shale
1570	3225	Lime & Shale
3225	3580	Lime
	<u>3580</u>	<u>RTD - D. & A.</u>

RECEIVED
 STATE CORPORATION COMMISSION
 JUN 10 1965
 CONSERVATION DIVISION
 Wichita, Kansas

 Set 8 5/8" used surface casing @ 270' with 225 sacks Sunset 2% Gel

I, Leslie Kite, do hereby certify that the above and foregoing is a true and correct copy of the log of the Christiansen B-#1 well, located E $\frac{1}{2}$ E $\frac{1}{2}$ NW of Section 18, Township 21 South, Range 12 West, Stafford County, Kansas, as reflected by the records of Leben Drilling, Inc.

Leslie Kite

Leslie Kite

STATE OF KANSAS)
) SS
 COUNTY OF BARTON)

Subscribed and sworn to before me, a Notary Public, in and for Barton County, Kansas, this 9th day of June, 1965.

Ulanda Nichols

Ulanda Nichols

My Commission Expires:
 April 1, 1967