

STATE OF KANSAS  
STATE CORPORATION COMMISSION

WELL PLUGGING RECORD


OR  
FORMATION PLUGGING RECORD

Give All Information Completely  
Make Required Affidavit  
Mail or Deliver Report to:  
Conservation Division  
State Corporation Commission  
800 Biting Building  
Wichita, Kansas

Strike out upper line  
when reporting plug-  
ging off formations.

Stafford County, Sec. 18 Twp. 21S Rge. (E) 12 (W)

Location as "NE $\frac{1}{4}$ NW $\frac{1}{4}$ SW $\frac{1}{4}$ " or footage from lines NE NE SE.  
Lease Owner Sterling Drilling Company, et al  
Lease Name Clark Well No. 1  
Office Address Sterling, Kansas  
Character of Well (completed as Oil, Gas or Dry Hole) Dry Hole  
Date well completed October 18, 19 48  
Application for plugging filed October 18, 19 48  
Application for plugging approved October 18, 19 48  
Plugging commenced October 18, 19 48  
Plugging completed October 18, 19 48  
Reason for abandonment of well or producing formation Dry Hole

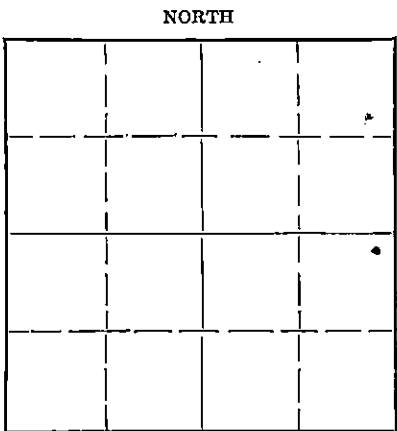

Locate well correctly on above  
Section Plat

If a producing well is abandoned, date of last production 19.....  
Was permission obtained from the Conservation Division or its agents before plugging was com-  
menced? Yes

Name of Conservation Agent who supervised plugging of this well C. D. Stough  
Producing formation..... Depth to top..... Bottom..... Total Depth of Well 3688 Feet  
Show depth and thickness of all water, oil and gas formations.

OIL, GAS OR WATER RECORDS

CASING RECORD

Formation	Content	From	To	Size	Put In	Pulled Out
				8-5/8"	279'	

Describe in detail the manner in which the well was plugged, indicating where the mud fluid was placed and the method or methods used in introducing it into the hole. If cement or other plugs were used, state the character of same and depth placed, from.....feet to.....feet for each plug set.

Filled with heavy mud to 240 feet. Cemented with 15 sacks cement through drill pipe. Filled with heavy mud to within 30 feet of surface. Cemented with 10 sacks cement at 30 feet. Cement within 5 feet from top.

RECEIVED  
Conservation Div.  
NOV 6 1948  
CORPORATION  
KANSAS

11-6-48

(If additional description is necessary, use BACK of this sheet)  
Correspondence regarding this well should be addressed to Sterling Drilling Company  
Address Sterling, Kansas

STATE OF Kansas, COUNTY OF Rice, ss.  
Rollin Mead (employee of owner) or (owner or operator) of the above-described well,  
being first duly sworn on oath, says: That I have knowledge of the facts, statements, and matters herein contained and the log of the above-described well as filed and that the same are true and correct. So help me God.

(Signature) Rollin Mead  
Sterling, Kansas  
(Address)

SUBSCRIBED AND SWORN to before me this 29th day of October, 19 48.  
Notary Public.

My commission expires September 17, 1949.

PLUGGING  
FILE SEC 18 T 21 R 12  
BOOK PAGE 63 LINE 31

WELL LOG ----- CLARK NO. 1

Location - NE NE SE of Section 18-21S-12W, Stafford County, Kansas.

Owner - Sterling Drilling Company, et al  
Contractor - Sterling Drilling Company

Commenced - 10-5-48  
Completed - 10-18-48 (plugged & abandoned)

Total Depth - 3688' ELEVATION - 1858 D.F.

LOG


CASING RECORD

0- 230 Sand and Clay  
 230- 280 Shale and Shells  
 280- 435 Red Shale  
 435- 925 Red Bed and Shale  
 925-1495 Shale and Shells  
 1495-1756 Lime  
 1756-1847 Lime and Shale  
 1847-1875 Lime, Sandy  
 1875-2880 Shale and Lime  
 2880-3125 Lime  
 3125-3205 Lime and Shale  
 3205-3249 Shale  
 3249-3331 Lime  
 3331-3355 Lime and Shale  
 3355-3480 Lime  
 3480-3535 Shale  
 3535-3544 Conglomerate  
 3544-3575 Chert  
 3575-3630 Lime and Chert  
 3630-3665 Chert  
 3665-3688 Lime and Chert

279' 8-5/8" Surface Pipe  
 Cemented with 230 Sacks Cement  
  
 Took Drill Stem Test in Kansas  
 City formation -- 3270-3331.  
 Recovered 30' mud - 30 minutes.

PRODUCTION

None. Dry and Abandoned.

 

I hereby certify that the above is a true and correct copy of Driller's Log of well drilled in the NE NE SE of Section 18, Township 21 South, Range 12 West, Stafford County, Kansas.

STERLING DRILLING COMPANY

By Roller Mead  
Vice-President

Subscribed and sworn to before me this 29th day of October, 1948.

J. M. Mullen  
Notary Public

My Commission Expires: 9-17-49

