

STATE OF KANSAS
STATE CORPORATION COMMISSION

WELL PLUGGING RECORD

Give All Information Completely
Make Required Affidavit
Mail or Deliver Report to:
Conservation Division
State Corporation Commission
800 Bittling Building
Wichita, Kansas


FORMATION PLUGGING RECORD

Strike out upper line
when reporting plugging
off formations.

Stafford County, Sec. 18 Twp. 21 Rge. 12 (E) W (W)

Location as "NE $\frac{1}{4}$ NW $\frac{1}{4}$ SW $\frac{1}{4}$ " or footage from lines CS $\frac{1}{2}$ SW NW
Lease Owner: Honaker Drilling Co., Inc.
Lease Name: Christiansen Well No. 1
Office Address: 2008 Lakin, Great Bend, Kansas
Character of Well (completed as Oil, Gas or Dry Hole): Dry Hole
Date well completed: May 29, 19 50
Application for plugging filed: May 29, 19 50
Application for plugging approved: May 29, 19 50
Plugging commenced: May 29, 19 50
Plugging completed: May 29, 19 50
Reason for abandonment of well or producing formation: Dry

NORTH

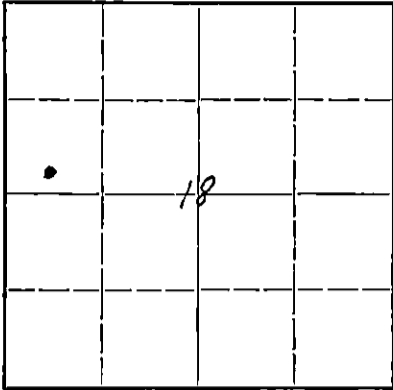

Locate well correctly on above Section Plat

If a producing well is abandoned, date of last production: 19
Was permission obtained from the Conservation Division or its agents before plugging was commenced?: Yes

Name of Conservation Agent who supervised plugging of this well: C. D. Stough
Producing formation: None Depth to top: Bottom: Total Depth of Well: 3590 Feet
Show depth and thickness of all water, oil and gas formations.

OIL, GAS OR WATER RECORDS

CASING RECORD

Formation	Content	From	To	Size	Put In	Pulled Out

Describe in detail the manner in which the well was plugged, indicating where the mud fluid was placed and the method or methods used in introducing it into the hole. If cement or other plugs were used, state the character of same and depth placed, from feet to feet for each plug set.

Hole was filled with heavy mud, Halliburton plug placed at 345', 20 sacks cement (hand mixed in $\frac{1}{2}$ barrel) poured thru drill pipe. Filled with heavy mud to 30' and another Halliburton plug set, 10 sacks cement run and pipe cut off 3' below ground.

JUN 19 1950

6-6-50

(If additional description is necessary, use BACK of this sheet)

Correspondence regarding this well should be addressed to: Honaker Drilling Co., Inc.
Address: 2008 Lakin, Great Bend, Kansas

STATE OF Kansas, COUNTY OF Barton, ss.
Joe J. Honaker (employee or owner) or (owner or operator) of the above-described well,

being first duly sworn on oath, says: That I have knowledge of the facts, statements, and matters herein contained and the log of the above-described well as filed and that the same are true and correct. So help me God.

(Signature) Joe J. Honaker


2008 Lakin, Great Bend, Kansas (Address)

SUBSCRIBED AND SWORN to before me this 5th day of June 19 50

Barton Carothers

Notary Public.

My commission expires November 28, 1953

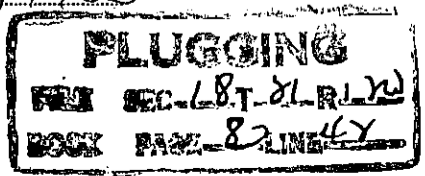

DRILLER'S LOG

Operator Honaker Drilling Co., Inc.

Contractor Honaker Drilling Co., Inc.
Great Bend, Kansas

Lease Christiansen #1

Further Description CS/2 SW NW of 18-21-12W, Stafford County, Kansas

	From	To
Surface Sand & Clay	0	135
Sand	135	220
Shells & Red Bed	220	346

Run 349' 8-5/8" casing, cemented with 250 sacks cement, 300# CaCl.

Shells & Red Bed	346	700
Anhydrite	700	715
Shale & Shells	715	820
Shale & Shells	820	950
Shells & Salt	950	1120
Shells	1120	1135
Shale & Shells	1135	1530
Shale & Shells	1330	1560
Broken Line	1560	1680
Lime & Shale	1680	1750
Lime & Shale	1750	1840
Broken Line	1840	1955
Lime & Shale	1955	2070
Lime & Shale	2070	2160

	From	To
Line & Shale	2160	2285
Line & Shale	2285	2425
Shale & Shells	2425	2565
Shale & Shells	2565	2655
Line & Shale	2655	2775
Broken Line	2775	2865
Lime & Shale	2865	2940
Lime & Shale	2940	3005
Broken Line	3005	3055
Shale & Line	3055	3115
Shale & Line	3115	3162
Broken Line	3162	3225
Shale & Line	3225	3300
Lime	3300	3555
Simpson Shale & Line	3555	3530

T. D. 3590'

(Above depths are Rotary Bushing Measurements)

The foregoing is correct to the best of my knowledge.

HONAKER DRILLING CO., INC.

By Joe J. Honaker
President

RECEIVED

COMMUNICATIONS SECTION

JUN 6 X 1950

STATE CORPORATION
COMMISSION
KANSAS

PLUGGING
FILE SEC 18 T 21 R 12W
PAGE 8 LINE 4