

15-009-05229-00-00

STATE OF KANSAS
STATE CORPORATION COMMISSION


WELL PLUGGING RECORD

Give All Information Completely
Make Required Affidavit
Mail or Deliver Report to:
Conservation Division
State Corporation Commission
212 North Market, Insurance Bldg.
Wichita, Kansas

BARTON

County. Sec. 4 Twp. 16S Rge. (E) 13 (W)

Location as "NE/CNW/SW" or footage from lines SW NE SE
Lease Owner REX & MORRIS DRILLING COMPANY, ET AL
Lease Name SCHULTZ Well No. 1
Office Address P. O. BOX 334, EL DORADO, KANSAS
Character of Well (completed as Oil, Gas or Dry Hole) DRY HOLE
Date well completed 12 JANUARY 19 61
Application for plugging filed 12 JANUARY 19 61
Application for plugging approved 12 JANUARY 19 61
Plugging commenced 12 JANUARY 19 61
Plugging completed 12 JANUARY 19 61
Reason for abandonment of well or producing formation DRY HOLE

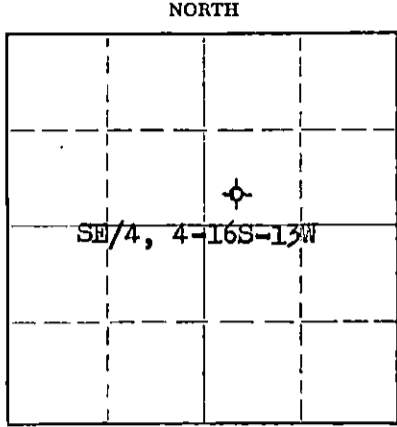

Locate well correctly on above Section Plat

If a producing well is abandoned, date of last production NONE 19
Was permission obtained from the Conservation Division or its agents before plugging was commenced? YES

Name of Conservation Agent who supervised plugging of this well LYALL SHIRK
Producing formation NONE Depth to top Bottom Total Depth of Well 3396 Feet
Show depth and thickness of all water, oil and gas formations.

OIL, GAS OR WATER RECORDS

CASING RECORD

FORMATION	CONTENT	FROM	TO	SIZE	PUT IN	PULLED OUT
SURFACE HOLE	WATER	SURFACE	336' RB	8 5/8" OD	331'	LEFT IN
(SEE ATTACHED LOG)						

Describe in detail the manner in which the well was plugged, indicating where the mud fluid was placed and the method or methods used in introducing it into the hole. If cement or other plugs were used, state the character of same and depth placed, from feet to feet for each plug set.

FILLED HOLE WITH DRILLING MUD TO 320', SET PLUG AND CEMENTED WITH 25 SACKS CEMENT, FILLED HOLE WITH DRILLING MUD TO 35', SET PIUG AND CEMENTED WITH 10 SACKS CEMENT, PUT 2 SACKS CEMENT IN RAT HOLE.

RECEIVED
STATE CORPORATION COMMISSION
2-9-61
FEB 9 1961
CONSERVATION DIVISION
Wichita, Kansas

(If additional description is necessary, use BACK of this sheet)
Name of Plugging Contractor REX & MORRIS DRILLING COMPANY
Address P. O. BOX 334, EL DORADO, KANSAS

STATE OF KANSAS, COUNTY OF BUTLER, ss. A. H. FISHER (employee of owner) or (owner or operator) of the above-described well, being first duly sworn on oath, says: That I have knowledge of the facts, statements, and matters herein contained and the log of the above-described well as filed and that the same are true and correct. So help me God.

(Signature) [Signature]
P. O. BOX 334, EL DORADO, KANSAS (Address)

SUBSCRIBED AND SWORN TO before me this 8TH day of FEBRUARY, 19 61

My commission expires 8 AUGUST 1962
ELIZABETH DESCHNER Notary Public

SCHULTZ #1

Rex & Morris Drilling Co.
and
Cooperative Refinery Assn.

Total Depth: 3396
Contractor: Rex & Morris Drilling Co.
Commenced: 1-4-61
Completed: 1-12-61
Initial Prod.: D. & A.

Location: SW NE SE
Section 4-16S-13W
Barton County, Kansas
Casing Record:
8 5/8 @ 336' w/200 sacks

FORMATION	DEPTH
Surface Hole	336
Shale	610
Shale and Red Rock	860
Anhydrite	890
Shale and Shells	1250
Shale and Lime	1695
Lime and Shale	2145
Shale and Lime	2370
Lime and Shale	2575
Shale and Lime	2726
Lime and Shale	2850
Lime	3065
Shale	3111
Lime	3305
Lime and Shale	3365
Lime (Arb.)	3396

T.D.

Ran GR - LL - MLL

RECEIVED
STATE CORPORATION COMMISSION
FEB 2 1961
CONSERVATION DIVISION
Wichita, Kansas

I hereby certify the foregoing statements are true and correct to the best of my knowledge and belief.

Rex & Morris Drilling Company

By Paul D. Koontz
Paul D. Koontz, Geologist

STATE OF KANSAS
COUNTY OF BUTLER, SS.

Subscribed and sworn to before me, a Notary Public, this 13th day of January, 1961.

Elizabeth Deschner
Elizabeth Deschner, Notary Public

My commission expires: August 8, 1962.