


15-009-20290-00-00

STATE OF KANSAS  
STATE CORPORATION COMMISSION

Form CP-4

WELL PLUGGING RECORD

Give All Information Completely  
Make Required Affidavit  
Mail or Deliver Report to:  
Conservation Division  
State Corporation Commission  
P. O. Box 17027  
Wichita, Kansas 67217  
NORTH

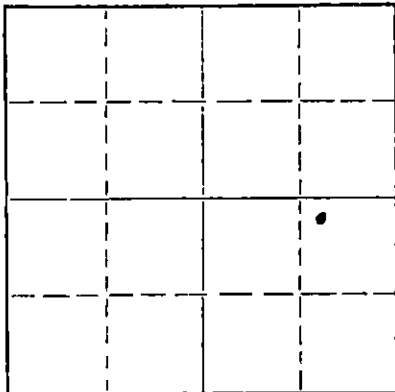

Locate well correctly on above  
Section Plat

Barton County. Sec. 4 Twp. 16 Rge. (E) 13 (W)  
Location as "NE/CNW/SE" or footage from lines NW NE SE  
Lease Owner Kathol Petroleum, Inc.  
Lease Name Schultz Well No. 1  
Office Address 900 Sutton Place, Wichita, Kansas 67202  
Character of Well (completed as Oil, Gas or Dry Hole) oil  
Date well completed \_\_\_\_\_ 19\_\_\_\_  
Application for plugging filed July 6 19 72  
Application for plugging approved \_\_\_\_\_ 19\_\_\_\_  
Plugging commenced September 13 19 72  
Plugging completed September 22 19 72  
Reason for abandonment of well or producing formation depleted

If a producing well is abandoned, date of last production \_\_\_\_\_ 19\_\_\_\_  
Was permission obtained from the Conservation Division or its agents before plugging was commenced? yes

Name of Conservation Agent who supervised plugging of this well Donald Truan  
Producing formation \_\_\_\_\_ Depth to top \_\_\_\_\_ Bottom \_\_\_\_\_ Total Depth of Well 3368 Feet  
Show depth and thickness of all water, oil and gas formations.

OIL, GAS OR WATER RECORDS

CASING RECORD

FORMATION	CONTENT	FROM	TO	SIZE	PUT IN	PULLED OUT
		0	231'	8 5/8"	231'	none
		0	3366'	5 1/2"	3366'	2521.03

Describe in detail the manner in which the well was plugged, indicating where the mud fluid was placed and the method or methods used in introducing it into the hole. If cement or other plugs were used, state the character of same and depth placed, from \_\_\_\_\_ feet to \_\_\_\_\_ feet for each plug set.

Sanded back to 3100' and dumped 5 sacks of cement.

Pumped in 15 sacks of mud and 100 sacks of cement.

RECEIVED  
STATE CORPORATION COMMISSION  
SEP 28 1972  
CONSERVATION DIVISION  
Wichita, Kansas

(If additional description is necessary, use BACK of this sheet)  
Name of Plugging Contractor PIPE PULLERS, INC.  
Address Box 486, Ellinwood, Kansas

STATE OF KANSAS, COUNTY OF BARTON, ss.  
Evelyn Roth (employee of owner) or (owner or operator) of the above-described well, being first duly sworn on oath, says: That I have knowledge of the facts, statements, and matters herein contained and the log of the above-described well as filed and that the same are true and correct. So help me God.

(Signature) Evelyn Roth  
Ellinwood, Kansas  
(Address)

SUBSCRIBED AND SWORN TO before me this 26th day of September, 19 72

My commission expires Feb. 10, 1975  
George A. Meyer Notary Public.

15-009-20290-00-00

DRILLERS LOG

No. 1 SCHULTZ


CASING RECORD:	COMPANY:	Kathol Petroleum, Inc.	DESCRIPTION:
8 5/8" @ 231' w/150 sacks cem.	CONTRACTOR:	Kathol Petroleum, Inc.	NW NE SE Sec. 4-16S-13W Barton Co., Ks.
5 1/2" @ 3366' w/125 sacks cem.	COMMENCED:	October 23, 1968	ELEVATION:
TOTAL DEPTH: 3368'	COMPLETED:	October 31, 1968	1906' K.B.
	I.P.	149 BOPD	

<u>FORMATION</u>	<u>FROM</u>	<u>TO</u>	<u>REMARKS</u>
surface soil	0	231	
clay	231	495	
shale	495	860	
Anhydrite	860	890	
shale & shells	890	1150	
shale w/lime	1150	1700	
lime & shale	1700	2600	
shale & lime	2600	2805	
lime	2805	2991	
lime & shale	2991	3045	
lime	3045	3368 R.T.D.	

**RECEIVED**  
 STATE CORPORATION COMMISSION  
 APR 14 1972  
 CONSERVATION DIVISION  
 Wichita, Kansas

I hereby certify that the above information is true and correct to the best of my knowledge.

KATHOL PETROLEUM, INC.

  
 Don D. Sawyer

Subscribed and sworn to before me this 24th day of June, 1969.

  
 Betty M. Maloney, Notary Public

My Commission Expires:

3/22/71

