


Give All Information Completely
Make Required Affidavit
Mail or Deliver Report to:
Conservation Division
State Corporation Commission
212 No. Market
Wichita, Kansas

WELL PLUGGING RECORD

Stafford County, Sec. 16 Twp. 21 Rge. 11 (E) WEST (W)

Location as "NE/CNW%SW%" or footage from lines NE NW NW
Lease Owner Leo G. Wetherill, Jr.
Lease Name SMTH ESTATE "B" Well No. 1
Office Address 2302 Power & Light Bldg. -K.C.5, Mo.
Character of Well (completed as Oil, Gas or Dry Hole) dry hole
Date well completed April 13, 19 69
Application for plugging filed " " 19 69
Application for plugging approved " " 19 69
Plugging commenced April 13, 19 69
Plugging completed " " 19 69
Reason for abandonment of well or producing formation

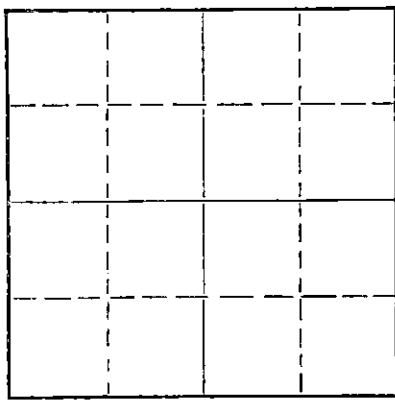

Locate well correctly on above Section Plat

If a producing well is abandoned, date of last production 19
Was permission obtained from the Conservation Division or its agents before plugging was commenced? yes

Name of Conservation Agent who supervised plugging of this well Ralph Warren
Producing formation Depth to top Bottom Total Depth of Well 3475 Feet
Show depth and thickness of all water, oil and gas formations.

OIL, GAS OR WATER RECORDS

CASING RECORD

FORMATION	CONTENT	FROM	SIZE	PUT IN	PULLED OUT

RECEIVED
STATE CORPORATION COMMISSION
APR 16 1969
CONSERVATION DIVISION
Wichita, Kansas

Describe in detail the manner in which the well was plugged, indicating where the mud fluid was placed and the method or methods used in introducing it into the hole. If cement or other plugs were used, state the character of same and depth placed, from feet to feet for each plug set.

Filled hole with heavy mud - 450'
Set plug, pumped 50 sacks cement thru drill pipe
Come up to 240' - 25 sacks cement pumped thru d.p.
Come up to 40' - set plug - good bridge - 10 sacks cement
2 sacks cement in rat hole.

(If additional description is necessary, use BACK of this sheet)

Name of Plugging Contractor
Address

STATE OF Kansas, COUNTY OF Barton, ss.
Larry Curtis (employee of owner) or (owner or operator) of the above-described well, being first duly sworn on oath, says: That I have knowledge of the facts, statements, and matters herein contained and the log of the above-described well as filed and that the same are true and correct. So help me God.

(Signature) Larry Curtis
Box 823 - Great Bend, Kansas
(Address)

SUBSCRIBED AND SWORN TO before me this 14th day of April, 19 69

Marathy M. Stager
Notary Public.

My commission expires 4-11-70

DRILLERS' WELL LOG

DATE COMMENCED: April 7, 1969
DATE COMPLETED: April 13, 1969

Leo G. Wetherill, Jr.
SMITH ESTATE "B" 1
NE NW NW
Sec. 16-21-11w
Stafford County, Kansas

0	-	180'	Sand
180	-	520'	Red Bed
520	-	543'	ANHYDRITE
543	-	1345'	Shale & Shells
1345	-	1783'	Shale & Lime
1783	-	2075'	Lime & Shale
2075	-	2715'	Shale & Lime
2715	-	2985'	Lime
2985	-	2990'	Shale
2990	-	3005'	Lime & Shale
3005	-	3020'	Lime
3020	-	3114'	Shale
3114	-	3130'	B. Lime
3130	-	3323'	Lime
3323	-	3341'	Shale
3341	-	3390'	Lime
3390	-	3433'	Conglomerate
3433	-	3440'	Chert
3440	-	3445'	Sand
3445	-	3464'	Shale
3464	-	3475'	Dolomite
3475	-		RTD

ELEVATION: 1775 K.B.

FORMATION TOPS

Anhydrite	520
Heebner	2985
Toronto	3005
Douglas	3020
B. Lime	3114
Kansas City-Lansing	3130
Base K. City	3390
Conglomerate	3402
Arbuckle	3464
RTD	3475'

RECEIVED
STATE CORPORATION COMMISSION
APR 16 1969
CONSERVATION DIVISION
Wichita, Kansas

SURFACE PIPE: Set 8-5/8",
28# at 264' with 225 sacks
cement, 2% gel.

A F F I D A V I T

STATE OF KANSAS
COUNTY OF BARTON) ss.

Larry Curtis, of lawful age, does swear and state that the facts and statements herein contained are true and correct to the best of his knowledge.

Larry Curtis

Subscribed and sworn to before me this 15 day of April, 1969

My Comm. Expires:
April 11, 1970.

Maureen M. Hogue
Notary Public