

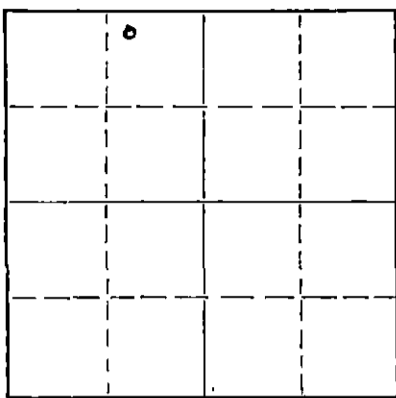
WELL PLUGGING RECORD

Give All Information Completely
Make Required Affidavit
Mail or Deliver Report to:
Conservation Division
State Corporation Commission
800 Bitter Building
Wichita, Kansas

Stafford County, Sec. 16 Twp. 21 Rge. 11 (X) W (W)

Location as "NE/CNW/SW" or footage from lines NW NE NW
Lease Owner LEO G. WETHERILL, JR.
Lease Name Smith Estate Well No. 24
Office Address 2208 Power & Light Bldg., K.C. 5, Missouri
Character of Well (completed as Oil, Gas or Dry Hole) Dry Hole
Date well completed March 25 19 66
Application for plugging filed March 25 19 66
Application for plugging approved March 25, 19 66
Plugging commenced March 25 19 66
Plugging completed March 25 19 66
Reason for abandonment of well or producing formation D. & A.

NORTH



Locate well correctly on above Section Plat

If a producing well is abandoned, date of last production _____ 19____
Was permission obtained from the Conservation Division or its agents before plugging was commenced? Yes

Name of Conservation Agent who supervised plugging of this well Mr. Archie Elving
Producing formation _____ Depth to top _____ Bottom _____ Total Depth of Well 3500 Feet
Show depth and thickness of all water, oil and gas formations.

OIL, GAS OR WATER RECORDS

CASING RECORD

FORMATION	CONTENT	FROM	TO	SIZE	PUT IN	PULLED OUT

Describe in detail the manner in which the well was plugged, indicating where the mud fluid was placed and the method or methods used in introducing it into the hole. If cement or other plugs were used, state the character of same and depth placed, from _____ feet to _____ feet for each plug set.

Filled hole with heavy mud to 250'
Set Plug - 1/4 sacks hulls and 25 sacks cement;
Filled hole to 40' with heavy mud.
Set Plug - 1/4 sack hulls and 10 sacks cement.
Plugged rat hole with 2 sacks cement.

RECORDED & INDEXED
STATE OF KANSAS
MAR 29 1966
3-29-66

(If additional description is necessary, use BACK of this sheet)

Name of Plugging Contractor _____
Address _____

STATE OF KANSAS COUNTY OF STAFFORD, ss.
L. O. Chubb (employee of owner) or (~~owner or operator~~) of the above-described well, being first duly sworn on oath, says: That I have knowledge of the facts, statements, and matters herein contained and the log of the above-described well as filed and that the same are true and correct. So help me God.

(Signature) L. O. Chubb
Box 823 - Great Bend, Kansas
(Address)

SUBSCRIBED AND SWORN TO before me this 28 day of March, 19 66

My commission expires June 24, 1967
Clair E. Stimson Notary Public.



W E L L L O G

DATE COMMENCED: March 18th, 1966
 DATE COMPLETED: March 25, 1966

Leo G. Wetherill, Jr.
 SMITH ESTATE #24
 NW NE NW Sec. 16-21-11w
 Stafford County, Kansas

0 -	190	Surface Clay & sand
190 -	512	Red Bed
512 -	539	ANHYDRITE
539 -	814	Red Bed
814 -	1610	Shale & Shells
1610 -	2120	Lime & Shale
2120 -	2703	Shale & Lime
2703 -	2802	Lime & Shale
2802 -	2976	Lime
2976 -	2996	Shale & Lime
2996 -	3010	Lime
3010 -	3107	Shale
3107 -	3126	Lime - Shale
3126 -	3376	Lime
3376 -	3461	Conglomerate
3461 -	3500	Chert

ELEVATION: 1767 K.B.

FORMATION DATA

Anhydrite	511
Heebner	2976
Brown Lime	3107
Lansing	3126
Conglomerate	3376
Viola	3461
R.T.D.	3500

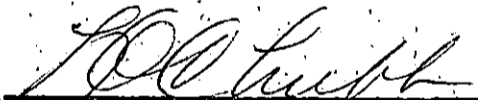
RECEIVED
 STATE CORPORATION COMMISSION
 MAY 23 1966
 CONSERVATION DIVISION
 Wichita, Kansas

SURFACE CASING: Set 8-5/8" casing @ 286' with 225 sacks cement.

A F F I D A V I T

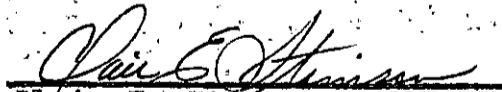
STATE OF KANSAS
 COUNTY OF BARTON) ss.

L. O. Chubb, of lawful age, does swear that the facts and statements herein contained are true and correct to the best of his knowledge.


 L. O. Chubb

Subscribed and sworn to before me this 28 day of March, 1966.

My Commission Expires:
June 24, 1967


 Clair E. Stinson - NOTARY PUBLIC