


WELL PLUGGING RECORD

Give All Information Completely  
Make Required Affidavit  
Mail or Deliver Report to:  
Conservation Division  
State Corporation Commission  
800 Bittling Building  
Wichita, Kansas

NORTH

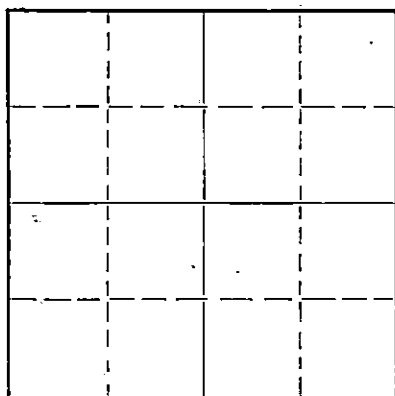

Locate well correctly on above  
Section Plat

Stafford County. Sec. 16 Twp. 21S Rge. (E) 11 (W)  
Location as "NE/CNW/SW" or footage from lines SW SW NE  
Lease Owner Shell Oil Company  
Lease Name C. P. Smith "B" Well No. 2  
Office Address Great Bend, Kansas  
Character of Well (completed as Oil, Gas or Dry Hole) Oil  
Date well completed September 20 1948  
Application for plugging filed March 15 1950  
Application for plugging approved March 17 1950  
Plugging commenced March 27 1950  
Plugging completed March 30, 1950  
Reason for abandonment of well or producing formation Oil depleted

If a producing well is abandoned, date of last production November 20 1949  
Was permission obtained from the Conservation Division or its agents before plugging was commenced? Yes

Name of Conservation Agent who supervised plugging of this well C. D. Stough  
Producing formation Arbuckle Depth to top 3397 Bottom          Total Depth of Well 3457 Feet  
Show depth and thickness of all water, oil and gas formations.

OIL, GAS OR WATER RECORDS

CASING RECORD

Formation	Content	From	To	Size	Put In	Pulled Out
<u>Arbuckle</u>	<u>I.P. 46 Oil &amp; 4% water</u>	<u>3395</u>	<u>3406</u>	<u>4 1/2"</u>	<u>3446'</u>	<u>2583'</u>

Describe in detail the manner in which the well was plugged, indicating where the mud fluid was placed and the method or methods used in introducing it into the hole. If cement or other plugs were used, state the character of same and depth placed, from          feet to          feet for each plug set.

Set bottom hole plug.  
Rocked hole from 3300' to 3285'. Ran 5 sacks of cement.  
Mudded hole to 200'. Set 15' rock bridge 200-185' and ran 15 sacks of cement.  
Mudded hole to 50' and ran 10 sacks of cement.

(If additional description is necessary, use BACK of this sheet)


Correspondence regarding this well should be addressed to Shell Oil Company  
Address c/o S. S. Mabry, Box 744, Great Bend, Kansas

STATE OF KANSAS, COUNTY OF BARTON, SS.  
S. S. Mabry (employee of owner) ~~RECORDER OF DEEDS~~ of the above-described well,  
being first duly sworn on oath, says: That I have knowledge of the facts, statements, and matters herein contained and the log of the above-described well as filed and that the same are true and correct. So help me God.

(Signature) [Handwritten Signature]  
(Address)         

SUBSCRIBED AND SWORN to before me this 6th day of April, 1950  
Betty Postlethwait  
Notary Public.

My commission expires January 24, 1953

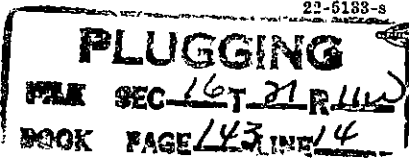

22-6188-s 9-48-10M APR 7 1950

4-7-50

SHELL, C. P. SMITH "B" #2  
 SW SW NE Section 16-21S-11W  
 330' SL: 330' WL  
 South Snider Field  
 Stafford County, Kansas

CASING RECORD

8 5/8" cem @ 225 with 150 sax: & 3% Aquagel.  
 4 1/2" cem@ 3446 with 100 sax;  
 perforated 3395-3410, 3413-18 & 3428-36.

0 - 4 Cellar  
 160 Sand  
 189 Shale  
 700 Red bed  
 1025 Shale & shells  
 1285 Salt & shale  
 1495 Shale & shells  
 1965 Lime & shale  
 2400 Shale & shells  
 2470 Lime & shale  
 2690 Shale & lime  
 TOP TOPEKA 2706  
 3025 Lime  
 TOP LANSING KANSAS CITY 3119  
 3120 Lime & shale  
 3365 Lime  
 TOP SOOY CONGLOMERATE 3374  
 3397 Lime & shale  
 TOP ARBUCKLE 3397  
 3451 Dolomite  
 3451=3450 S.L.C.  
 3450=3447 D. F. Correction  
 3457 Dolomite T.D.

**PLUGGING**  
 SEC 16 T. 21 R. 11 W.  
 PAGE 143 LINE 14

MAR 16 1950