

WELL PLUGGING RECORD

OR

FORMATION PLUGGING RECORD


Strike out upper line
when reporting plug-
ging of formations.

Give All Information Completely
Make Required Affidavit
Mail or Deliver Report to:
Conservation Division
State Corporation Commission
800 Bittling Building
Wichita, Kansas

Stafford County. Sec. 16 Twp. 21 Rge. 11 (E) (W)

Location as "NE $\frac{1}{4}$ NW $\frac{1}{4}$ SW $\frac{1}{4}$ " or footage from lines 440' North & 1435' East of SW
Lease Owner Cities Service Oil Company Cora. Sec.
Lease Name Smith "E" Well No. 6-B
Office Address Bartlesville, Okla.
Character of Well (completed as Oil, Gas or Dry Hole) Dry Hole
Date, well completed April 15, 1941 19
Application for plugging filed April 27, 1941 19
Application for plugging approved April 28, 1941 19
Plugging Commenced May 3, 1941 19
Plugging Completed May 4, 1941 19
Reason for abandonment of well or producing formation Dry Hole

NORTH

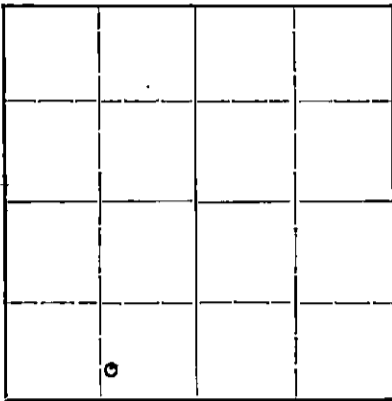

Locate well correctly on above
Section Plat

If a producing well is abandoned, date of last production 19
Was permission obtained from the Conservation Division or its agents before plugging was com-
menced? Yes

Name of Conservation Agent who supervised plugging of this well C. T. Alexander
Producing formation Arbuckle Lime Depth to top 3443' Bottom Total Depth of Well 3445 Feet
Show depth and thickness of all water, oil and gas formations.


OIL, GAS OR WATER RECORDS

CASING RECORD

Formation	Content	From	To	Size	Put In	Pulled Out
				8 5/8"	290'	None
				5 1/2"	3376'	1087' 9"

Describe in detail the manner in which the well was plugged, indicating where the mud fluid was placed and the method or methods used in introducing it into the hole. If cement or other plugs were used, state the character of same and depth placed, from feet to feet for each plug set.

Plugged with thirteen sacks cement from 3445' to 3335'; mud from 3335' to 300', 2' wood plug and rock to 290'; 15 sacks cement from 290' to 237'; mud from 237' to 15'; rock to 8'; cement to base of cellar, with metal cap welded on top.

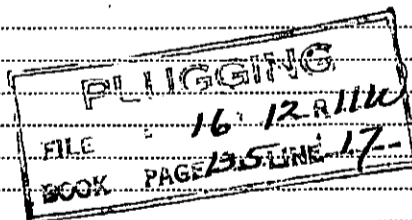

MAY 17 1941
5-17-41

(If additional description is necessary, use BACK of this sheet)

Correspondence regarding this well should be addressed to R. C. Hauber
Address Cities Service Oil Company, Great Bend, Kansas

STATE OF Kansas COUNTY OF Barton, ss.
A. P. Bates (employee of owner) or (owner or operator) of the above-described well,

being first duly sworn on oath, says: That I have knowledge of the facts, statements, and matters herein contained and the log of the above-described well as filed and that the same are true and correct. So help me God.

(Signature) A. P. Bates

Chase, Kansas
(Address)

SUBSCRIBED AND SWORN to before me this 16 day of May, 1941

C. B. Bixby
Notary Public.

My Commission Expires Sept. 26, 1942

My commission expires



WELL RECORD

Company Cities Service Oil Co. Well No. 6 Farm Smith "B"
 Location 440' north & 1485' east of SW Corner Sec. 16 T. 21 R. 11W
 Elevation 1752 County Stafford State Kansas
 Drlg. Comm. March 29, 1941 Contractor R. W. Rine Drilling Company
 Drlg. Comp. April 14, 1941 Acid None
 T. D. 3445' Initial Prod. Dry - P. & A.

CASING RECORD:

8-5/8" @ 290' con. 125 ex Monarch
 & 25 ex Quickset;
 recent top 100' with
 110 ex High Early
 5-1/2" @ 3376' con. 75 ex Ash Grove;
 pulled 1379' of 5-1/2".

Top Sand 3391
 Base Sand 3413
 500' water 1 hr. at 3408.
 1500' water 3 hrs. at 3408.
 2500' water at 3410.

FORMATION RECORD:

sand, shale & shells 0-220
 red bed & shells 290
 red bed 645
 shale & shells 1050
 salt & shale 1260
 shale & shells 1741
 lime broken 1845
 shale & shells 1997
 shale 2618
 shale & shells 2863
 lime 2940
 lime broken 3037
 lime & shale 3124
 lime 3195
 lime broken 3302
 lime 3377
 3377 Rot. TD = 3377 SLM
 chert (show oil) 3379
 chert & red rock 3383
 sand 3405
 lime & sand 3408
 sand 3423
 lime & chert 3428
 shale 3431
 lime & chert 3434
 conglomerate 3435
 shale 3440
 lime 3443
 shale 3444
 lime 3445

Top Arbuckle 3443
 Penetration 2'
 Total Depth 3445

Syfo: 500' 0°
 1000' 0°
 1500' 0°
 2000' 0°
 2500' 0°
 3000' 0°

T. D.
PLUGGING
 FILE 16-12-R1114
 BOOK PAGE 35 LINE 17