


WELL PLUGGING RECORD

Give All Information Completely
Make Required Affidavit
Mail or Deliver Report to:
Conservation Division
State Corporation Commission
211 No. Broadway
Wichita, Kansas

NORTH

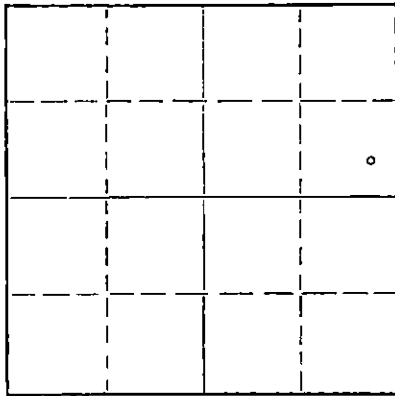

Locate well correctly on above
Section Flat

Stafford County. Sec. 16 Twp. 21 Rge. 11 (X) W (W)
Location as "NE/CNW%SW%" or footage from lines SE SE NE
Lease Owner Leo G. Wetherill, Jr.
Lease Name SMITH ESTATE Well No. 19
Office Address 2208 Power & Light Bldg., Kansas City 5, Mo.
Character of Well (completed as Oil, Gas or Dry Hole) Dry Hole
Date well completed November 30 19 63
Application for plugging filed November 30 19 63
Application for plugging approved " " 19 63
Plugging commenced November 30, 19 63
Plugging completed November 30 19 63
Reason for abandonment of well or producing formation dry hole

If a producing well is abandoned, date of last production _____ 19____
Was permission obtained from the Conservation Division or its agents before plugging was commenced? Yes

Name of Conservation Agent who supervised plugging of this well Mr. Elving
Producing formation _____ Depth to top _____ Bottom _____ Total Depth of Well 3500 Feet
Show depth and thickness of all water, oil and gas formations.

OIL, GAS OR WATER RECORDS

CASING RECORD

FORMATION	CONTENT	FROM	TO	SIZE	PUT IN	PULLED OUT

Describe in detail the manner in which the well was plugged, indicating where the mud fluid was placed and the method or methods used in introducing it into the hole. If cement or other plugs were used, state the character of same and depth placed, from _____ feet to _____ feet for each plug set.

Filled hole with heavy mud
Set plug and 1/4 sack of hulls at 275'
Cemented with 25 sacks of cement thru drill pipe
Filled hole with heavy mud to 40'
Set Plug and 1/4 sack of hulls and cemented with 10 sacks cement.
Plugged rat hole with 2 sacks of cement

RECEIVED
STATE CORPORATION COMMISSION

DEC 4 1963
12-4-63
CONSERVATION DIVISION
Wichita, Kansas

(If additional description is necessary, use BACK of this sheet)

Name of Plugging Contractor _____
Address _____

STATE OF KANSAS, COUNTY OF BARTON, ss.
L. O. Chubb (employee of owner) or (~~owner~~) of the above-described well, being first duly sworn on oath, says: That I have knowledge of the facts, statements, and matters herein contained and the log of the above-described well as filed and that the same are true and correct. So help me God.

(Signature) [Signature]

Box 823, Great Bend, Kansas
(Address)

SUBSCRIBED AND SWORN TO before me this 2nd day of December, 1963.

[Signature]
Clair E. Stimson Notary Public.

My commission expires 6-24-67



W E L L L O G

Date Commenced: November 23, 1963
Date Completed: November 30, 1963

Leo G. Wetherill, Jr.
SMITH ESTATE #19
SE SE NE Sec. 16-21-11w
Stafford County, Kansas

ELEVATION: 1752 K.B.

0	-	40'	Surface Clay
40	-	125'	Sand
125	-	175'	Sand & Shale
175	-	482'	Red Bed
482	-	513'	ANHYDRITE
513	-	670'	Red Bed Shale
670	-	1650'	Shale & Shells
1650	-	2050'	Lime Shale
2050	-	2300'	Shale
2300	-	2700'	Lime Shale
2700	-	2947'	Lime
2947	-	2952'	Shale
2952	-	2965'	Lime Shale
2965	-	2977'	Lime
2977	-	3078'	Shale
3078	-	3095'	Lime Shale
3095	-	3351'	Lime
3351	-	3424'	Chert Shale
3424	-	3500'	Chert & Shale RTD

Formation Data

Anhydrite	482
Heebner	2947
Brown Lime	3078
Lansing	3095
Conglomerate	3352
Viola	3424
R.T.D.	3500

Surface Casing: Set 8-5/8"
Casing at 284' with 220 sacks
cement

RECEIVED
STATE CORPORATION COMMISSION

DEC 4 1963


A F F I D A V I T

CONSERVATION DIVISION
Wichita, Kansas

STATE OF KANSAS

COUNTY OF BARTON) ss.

I, L. O. Chubb, being of lawful age, do swear that the facts and statements herein contained are true and correct to the best of my knowledge.

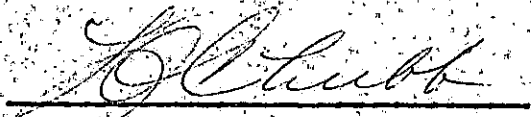

Subscribed and sworn to before me this 2nd day of December, 1963.

My Comm. Expires:
June 24, 1967


Clair E. Stimson-NOTARY PUBLIC