

STATE OF KANSAS
STATE CORPORATION COMMISSION

WELL PLUGGING RECORD


Give All Information Completely
Make Required Affidavit
Mail or Deliver Report to:
Conservation Division
State Corporation Commission
800 Bittling Building
Wichita, Kansas

OR
FORMATION PLUGGING RECORD

Strike out upper line
when reporting plug-
ging off formations.

STAFFORD County. Sec. 16 Twp. 21S Rge. (E) 11 (W)

Location as "NE $\frac{1}{4}$ NW $\frac{1}{4}$ SW $\frac{1}{4}$ " or footage from lines. NE NE NE $\frac{1}{2}$
Lease Owner. SHELL OIL CO., INC.
Lease Name. C. P. SMITH "B" Well No. 1
Office Address. BOX 744, GREAT BEND, KANSAS
Character of Well (Completed as Oil, Gas or Dry Hole). DRY HOLE
Date, well completed. 12-29 1934
Application for plugging filed. 1-7 1934
Application for plugging approved. 12-30 1934
Plugging Commenced. 12-29 1934
Plugging Completed. 12-29 1934
Reason for abandonment of well or producing formation. DRY HOLE

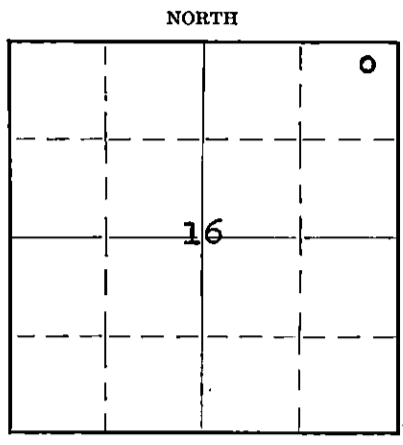

Locate well correctly on above
Section Plat

If a producing well is abandoned, date of last production. 193.
Was permission obtained from the Conservation Division or its agents before plugging was com-
menced? YES

Name of Conservation Agent who supervised plugging of this well. G. T. Alexander
Producing formation. Arbuckle Dolomite Depth to top. 3624 Bottom. Total Depth of Well. 3631 Feet.
Show depth and thickness of all water, oil and gas formations.

OIL, GAS OR WATER RECORDS

CASING RECORD

Formation	Content	From	To	Size	Put In	Pulled Out
Arbuckle Dolomite	Dry	3624	3631	8 5/8"	225'	None

Describe in detail the manner in which the well was plugged, indicating where the mud fluid was placed and the method or methods used in introducing it into the hole. If cement or other plugs were used, state the character of same and depth placed, from feet to feet for each plug set.

FILLED HOLE WITH HEAVY MUD, SET DRY HOLE
PLUG AT 225 FEET AND CAPPED WITH 15 SACKS
OF CEMENT. FILLED SURFACE CASING WITH MUD
AND CAPPED WITH 10 SACKS OF CEMENT.

PLUGGING
FILE SEC 16 T21 R11W
BOOK PAGE 125 LINE 30

STATE OF KANSAS
COUNTY OF BARTON
JAN 9 1941
1-9-41

(If additional description is necessary, use BACK of this sheet)
Correspondence regarding this well should be addressed to. Shell Oil Co., Inc.
Address. c/o W. M. Gholson, Box 744, Great Bend, Kansas

STATE OF KANSAS, COUNTY OF BARTON, ss.
W. M. Gholson (employee of owner) of the above-described well,

being first duly sworn on oath, says: That I have knowledge of the facts, statements, and matters herein contained and the log of the above-described well as filed and that the same are true and correct. So help me God.

(Signature) *W. M. Gholson*

Box 744, Great Bend, Kansas (Address)

SUBSCRIBED AND SWORN to before me this 7th day of January, 1941

My commission expires 12-1-44

Marie M. Clayton
Notary Public.

Shell, C. P. Smith "B" #1,
NE NE NE 16-21S-11W, Wildcat,
Stafford County, Kansas

Casing Record

8 5/8" cem. 225' with 100 sax &
2 Aquagel.

- 0 - 180 sand
- 225 red bed
- 230 red rock
- 585 red rock & shale
- 900 shale, anhydrite streaks & sand
- 1010 shale & anhydrite
- 1037 shale & salt
- 1152 salt
- 1315 salt & shale
- 1380 shale & shells
- 1490 shale & shells & anhydrite streaks
- 1562 shale & shells & anhydrite
- 1965 lime & shale
- 2013 broken lime & shale
- 2103 lime & shale
- 2258 shale & lime streaks
- 2672 lime & shale
- 2730 lime & chert streaks
- 2771 lime & chert
- 2771-2770 S.L. Correction
- 2800 lime
- 2835 dolomite, limy
- 2875 lime
- 2885 dolomite
- 2895 lime
- 2900 lime & chert streaks
- 2946 lime & chert
- 2975 lime
- 2990 lime & chert
- 3031 lime
- 3060 lime & shale
- 3070 sand
- 3090 lime & shale
- 3372 lime
- Top Lansing Kansas City 3112'
- Top Sooy Conglomerate 3372'
- 3375 V.C. shale, lime pebbles & sand grains.
- 3467 V.C. shale, chert & lime pebbles
- Top Viola Formation 3467'
- 3522 chert, shaly
- Top Simpson 3522'
- 3525 sand, slightly shaly, no shows
- 3527 shale
- 3538 shale, sandy
- 3544 shale
- 3548 sand, shaly, no shows
- 3558 shale, sandy

- 3607 shale, streaks sandy
- 3624 shale, streaks sandy, & chert
- Top Arbuckle Dolomite 3624'
- 3625 dolomite, pyritic
- 3631 dolomite, no oil shows, sulphur odor, T.D.

STATE OF KANSAS, COUNTY OF BARTON, ss.
W. M. Gholson, employee of owner of the above-described well, being first duly sworn on oath, says: That I have knowledge of the facts, statements, and matters herein contained and the log of the above-described well as filed and that the same are true and correct. So help me God.

SHELL OIL CO., INCORPORATED

By W. M. Gholson
Superintendent

Subscribed and Sworn to before me this 7th day of January, 1941.

W. M. Stanton
Notary Public

My commission expires 12-1-44.



PLUGGING
FILE SEC. 16T 21R 11W
BOOK PAGE 125 LINE 30