

STATE OF KANSAS  
STATE CORPORATION COMMISSION


WELL PLUGGING RECORD

Give All Information Completely  
Make Required Affidavit  
Mail or Deliver Report to:  
Conservation Division  
State Corporation Commission  
800 Bittig Building  
Wichita, Kansas

Stafford County. Sec. 20 Twp. 21 Rge. 11 (E/W) (W)

Location as "NE/CNW/SW" or footage from lines SE SE SE  
Lease Owner Isern Brothers  
Lease Name Richardson Well No. 1  
Office Address Box 45, Ellinwood, Kansas  
Character of Well (completed as Oil, Gas or Dry Hole) Dry Hole  
Date well completed August 1, 1956 19  
Application for plugging filed August 1, 1956 19  
Application for plugging approved August 1, 1956 19  
Plugging commenced August 1, 1956 19  
Plugging completed August 1, 1956 19  
Reason for abandonment of well or producing formation Dry Hole

NORTH

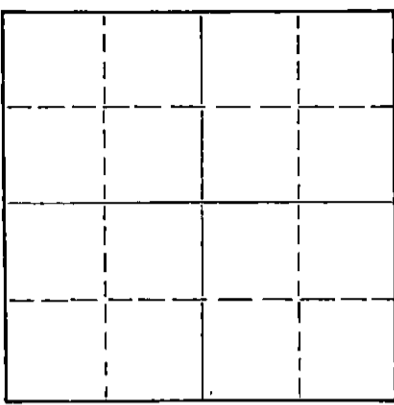

Locate well correctly on above  
Section Plat

If a producing well is abandoned, date of last production \_\_\_\_\_ 19\_\_\_\_  
Was permission obtained from the Conservation Division or its agents before plugging was commenced? yes

Name of Conservation Agent who supervised plugging of this well Mr. Brundige  
Producing formation \_\_\_\_\_ Depth to top \_\_\_\_\_ Bottom \_\_\_\_\_ Total Depth of Well 3529 Feet  
Show depth and thickness of all water, oil and gas formations.

OIL, GAS OR WATER RECORDS

CASING RECORD

FORMATION	CONTENT	FROM	TO	SIZE	PUT IN	PULLED OUT
	Surface Pipe	0	218'	8-5/8"	218'	None

Describe in detail the manner in which the well was plugged, indicating where the mud fluid was placed and the method or methods used in introducing it into the hole. If cement or other plugs were used, state the character of same and depth placed, from \_\_\_\_\_ feet to \_\_\_\_\_ feet for each plug set.

Filled hole with heavy mud to 210'.  
Bridged hole at 210'. Ran 15 sacks  
cement 210' up. Bridge hole at 35',  
ran 10 sacks cement. Plug 35' to  
base of cellar.

(If additional description is necessary, use BACK of this sheet)

Name of Plugging Contractor Isern Drilling Company  
Address Box 45, Ellinwood, Kansas

STATE OF KANSAS COUNTY OF BARTON  
I. M. M. Shropshire (employee of owner) or owner/operator of the above-described well, being first duly sworn on oath, says: That I have knowledge of the facts, statements, and matters herein contained and the log of the above-described well as filed and that the same are true and correct. So help me God.

(Signature) M. M. Shropshire  
Lyons, Kansas (Address)

SUBSCRIBED AND SWORN to before me this 2nd day of August, 1956

My commission expires July 7, 1960

J. Rader Notary Public.

RECEIVED  
STATE CORPORATION COMMISSION

AUG 7 1956

CONSERVATION DIVISION  
Wichita, Kansas

8-7-56

PLUGGING  
FILE SEC 20 T 21 R 11 W  
BOOK PAGE 86 LINE 17

WELL LOG

ISERN BROTHERS, OWNER. - RICHARDSON #1  
 SE/4 SE/4 SE/4 Section 20, Township 21, Range 11W,  
 Rice County, Kansas

ELEVATION: 1743 DF

Figures indicate bottom of formation  
 0 to

- 100 sand
- 190 sand & shale
- 221 shale & shells
- 475 Red rock
- 505 Anhydrite
- 1160 shale & shells
- 1325 salt
- 1365 shale & shells
- 1710 lime & shale
- 1735 sand
- 1763 lime & shale
- 1773 sand
- 2180 lime & shale
- 2690 shale & shells
- 3055 lime & shale
- 3124 shale
- 3145 Brown lime
- 3150 Lansing lime
- 3450 lime & shale
- 3506 chert, lime & shale
- 3529 chert
- 3529 Rotary TD D&A

PIPE RECORD:

8-5/8" set at 218'  
 Cemented with 175 sacks cement,  
 400# Calcium Chloride  
 July 25, 1956

Rotary Commenced 7-25-56  
 Completed 8-1-56

STATE OF KANSAS )  
 COUNTY OF BARTON ) SS

I, M. M. Shropshire, Drilling Superintendent of the above-described well, being first duly sworn on oath, declare: That I have knowledge of the facts, statements and matters herein contained pertaining to the log of the above-described well, as filed, and that the same are true and correct.

M. M. Shropshire

Subscribed and Sworn to before me this 2nd day of August, 1956.

[Signature]  
 Notary Public

My commission expires July 7, 1960

PLUGGING			
FILE	SEC 20	T. 21	R. 11W
BOOK	PAGE 86	LINE	17

RECEIVED  
 STATE CORPORATION COMMISSION  
 AUG 7 1956  
 CONSERVATION DIVISION  
 Wichita, Kansas