

STATE OF KANSAS
STATE CORPORATION COMMISSION

Give All Information Completely
Make Required Affidavit
Mail or Deliver Report to:
Conservation Division
State Corporation Commission
212 No. Market
Wichita, Kansas

WELL PLUGGING RECORD

Pawnee County, Sec. 27 Twp. 21 Rge. 16W (E) (W)

Location as "NE/CNW/SW" or footage from lines SW NE SW

Lease Owner Sun Oil Company

Lease Name Cossman Well No. 1

Office Address 1720 S. Bellaire, Suite 300, Denver, CO 80222

Character of Well (completed as Oil, Gas or Dry Hole) Oil

Date well completed 2-13 19 53

Application for plugging filed 12-16 19 74

Application for plugging approved 12-20 19 74

Plugging commenced 1-4 19 75

Plugging completed 1 16 19 75


Reason for abandonment of well or producing formation State Regulations

Require Plugging

If a producing well is abandoned, date of last production 19

Was permission obtained from the Conservation Division or its agents before plugging was commenced? Yes

NORTH

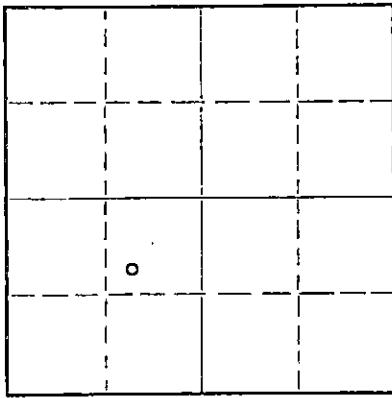

Locate well correctly on above Section Plat

Name of Conservation Agent who supervised plugging of this well Leo Massey

Producing formation Arbuckle Depth to top 3853 Bottom 3856 Total Depth of Well 3856 Feet

Show depth and thickness of all water, oil and gas formations.

OIL, GAS OR WATER RECORDS

CASING RECORD

FORMATION	CONTENT	FROM	TO	SIZE	PUT IN	PULLED OUT
		0	933	8 5/8	933	None
		0	3853	5 1/2	3853	1948

Describe in detail the manner in which the well was plugged, indicating where the mud fluid was placed and the method or methods used in introducing it into the hole. If cement or other plugs were used, state the character of same and depth placed, from feet to feet for each plug set.

Dumped 35 bbls. of salt water down casing. Pulled 61 joints of 5 1/2" casing. Pumped 20 sacks of gel and 140 sacks of 60/40 pos to surface. Well P & A

RECEIVED
STATE CORPORATION COMMISSION

1975

1-23-75

CONSERVATION DIVISION
Wichita, Kansas

(If additional description is necessary, use BACK of this sheet)

Name of Plugging Contractor Charlie Crowe Drilling Company

Address P. O. Box 706, Hays, Kansas

STATE OF _____, COUNTY OF _____, ss.

(employee of owner) or (owner or operator) of the above-described well, being first duly sworn on oath, says: That I have knowledge of the facts, statements, and matters herein contained and the log of the above-described well as filed and that the same are true and correct. So help me God.

(Signature) *[Handwritten Signature]*

(Address)

SUBSCRIBED AND SWORN TO before me this 20th day of January, 1975

[Handwritten Signature]

Notary Public.

RECEIVED
STATE CORPORATION COMMISSION
DEC 14 1973
CONSERVATION DIVISION
Wichita, Kansas

CONTRACTOR'S WELL LOG

COMPANY:
OPERATOR:
FARE:
LOCATION:

Mid-Continent Petroleum Corporation
Hingrove Petroleum Corporation
Cassan #1
SW NE SW Section 27-21-16
Pawnee County, Kansas

COMPLETED:
DATE:

January 24-1953
February 7, 1953

0	90	Sand
90	110	Shale
110	365	Shale and sand
365	430	Shale
430	508	Sand
508	650	Red bed and sand
650	698	Red bed
698	712	Shale and anhydrite
712	730	Shale
730	850	Blue shale and shells
850	994	Shale and shells
994	1010	Anhydrite
1010	1520	Shale and shells
1520	1675	Red bed and shale
1675	1835	Shale and shells
1835	1870	Lime
1870	2210	Lime and shale
2210	2345	Lime
2345	2410	Lime and shale
2410	2650	Shale and shells
2650	3135	Shale and lime
3135	3769	Lime
3769	3800	Conglomerate and lime
3800	3855	Conglomerate
3855	3896	Artificial
	3896	Rotary Total Depth

Bot 9 1/4" at 8 5/8", cemented with 500 sacks of cement.

Bot 5 1/2" at 2854' cemented with 125 sacks of cement.

STATE OF KANSAS

COUNTY OF SEDGWICK

SS

I, GEORGE L. HULLIER, do hereby certify that the above and foregoing is a true and correct copy of the log of the Cassan #1 Section 27-21-16, Pawnee County, Kansas as reflected by the files of the Hingrove Petroleum Corporation.

MANAGER, PETROLEUM CORPORATION

By George L. Hullier
Secretary, Hingrove

Subscribed and sworn to before me a Notary Public in and for Sedgewick County, Kansas, this 16th day of February, 1953.

My Commission Expires: November 14, 1955

Mary L. Gunn
Notary Public