


STATE OF KANSAS  
STATE CORPORATION COMMISSION

15.145.04125.0000  
Form CP-4

Give All Information Completely  
Make Required Affidavit  
Mail or Deliver Report to:  
Conservation Division  
State Corporation Commission  
212 No. Market  
Wichita, Kansas

WELL PLUGGING RECORD

NORTH

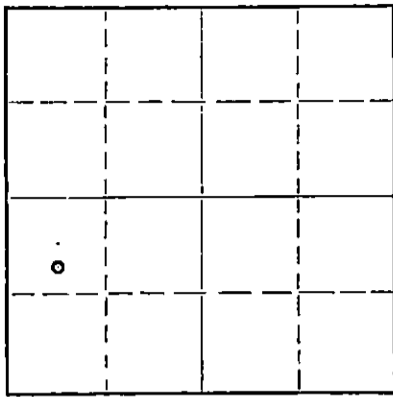

Locate well correctly on above  
Section Plat

Pawnee County, Sec. 27 Twp. 21 Rge. 16 (E) W (W)

Location as "NE/CNW%SW%" or footage from lines S 1/2 NW SW

Lease Owner Sun Oil Company

Lease Name Cossman Well No. 2

Office Address 1720 S. Bellaire, Suite 300, Denver, Colorado 80222

Character of Well (completed as Oil, Gas or Dry Hole) Oil

Date well completed 4-1 19 53

Application for plugging filed 12-16 19 74

Application for plugging approved 12-20 19 74

Plugging commenced 1-7 19 75

Plugging completed 1-16 19 75

Reason for abandonment of well or producing formation State Regulations Require Plugging

If a producing well is abandoned, date of last production 19

Was permission obtained from the Conservation Division or its agents before plugging was commenced? Yes

Name of Conservation Agent who supervised plugging of this well Leo Massey

Producing formation Arbuckle Depth to top 3863 Bottom 3881 Total Depth of Well 3881 Feet

Show depth and thickness of all water, oil and gas formations.

OIL, GAS OR WATER RECORDS

CASING RECORD

FORMATION	CONTENT	FROM	TO	SIZE	PUT IN	PULLED OUT
		0	990	10 3/4	990	None
		0	3863	5 1/2	3863	2145

Describe in detail the manner in which the well was plugged, indicating where the mud fluid was placed and the method or methods used in introducing it into the hole. If cement or other plugs were used, state the character of same and depth placed, from \_\_\_\_\_ feet to \_\_\_\_\_ feet for each plug set.

Dumped 30 gallons of sand to fill open hole. Plug back total depth was 3850'. Dumped 4 sacks of cement and began to work casing. Shot pipe off at 2140'. Pulled 66 joints of 5 1/2" casing. Pumped 35 sacks of gel and 140 sacks of 60/40 pos to surface. Well P & A.

RECEIVED  
STATE CORPORATION COMMISSION

48 23 1975

1-23-75

CONSERVATION DIVISION  
Wichita, Kansas

(If additional description is necessary, use BACK of this sheet)

Name of Plugging Contractor Charlie Crowe Drilling Co.

Address P. O. Box 706 Hays, Kansas

STATE OF \_\_\_\_\_, COUNTY OF \_\_\_\_\_, ss.

\_\_\_\_\_, (employee of owner) or (owner or operator) of the above-described well, being first duly sworn on oath, says: That I have knowledge of the facts, statements, and matters herein contained and the log of the above-described well as filed and that the same are true and correct. So help me God.

(Signature) [Signature]

(Address)

SUBSCRIBED AND SWORN TO before me this 20<sup>th</sup> day of January, 19 75

My Commission expires Nov. 22, 1975

My commission expires \_\_\_\_\_

Mary Marson

Notary Public.

RECEIVED  
STATE CORPORATION COMMISSION

DEC 14 1973  
CONSERVATION DIVISION  
Wichita, Kansas

STATE OF KANSAS  
STATE CORPORATION COMMISSION CONSERVATION DIVISION  
800 Bitting Building, Wichita 2, Kansas

WELL REPORT

To be immediately reported on the completion of every well drilled for oil and gas purposes in the State of Kansas. Data will be furnished to the Petroleum Administrator for Defense, Washington, D. C. Mail 2 copies of this report to the STATE CORPORATION COMMISSION, CONSERVATION DIVISION, 800 BITTING BLDG., WICHITA 2, KANSAS.

1. NAME OF OPERATOR Mid-Continent Petroleum Corp.  
Address: Street or Box No. 512 Amphoux Bldg.  
City: Wichita State Kansas

2. DESCRIPTION OF LEASE  
Name of Lease J. P. Gosman  
Legal Description N/2 Sec. 27 Twp. 21 Rge. 10E  
County Harmon  
Field Laredo

3. DESCRIPTION OF WELL  
Location on the lease C 2/2 TR 27  
Number of the well 22  
Date well was commenced 2-21-53  
Date well was completed 8-14-53  
Total Depth of the well 5275'  
Type of Well Oil  Gas  Dry  Disposal  Input

4. TUBULAR PIPE LEFT IN WELL

Size of Casing	10 5/4"	Weight	82.76#	Grade	H-20	Overall length	991'
Size of Casing	8 1/2"	Weight	14#	Grade	J-25	Overall length	3800'
Size of Casing		Weight		Grade		Overall length	
Size of Casing		Weight		Grade		Overall length	
Size of Tubing	2 7/8"	Weight	6.8#	Grade	J-25	Overall length	3800'

5. CEMENTING DATA ON CASING LEFT IN THE WELL

Size of Casing	10 5/4"	No. ft. cemented	991'	with	600	sacks
Size of Casing	8 1/2"	No. ft. cemented	3800'	with	125	sacks
Size of Casing		No. ft. cemented		with		sacks
Size of Casing		No. ft. cemented		with		sacks
Size of Tubing		No. ft. cemented		with		sacks

6. CERTIFICATE

I hereby certify the foregoing statements are true and correct to the best of my knowledge and belief.

R. X. Mankey  
Title: Dist. Supt.

Subscribed and sworn to before me, a Notary Public, this 18 day of March, 1953.

\_\_\_\_\_  
Notary Public

My Commission expires \_\_\_\_\_

DATA AND AFFIDAVIT

(One Copy)

(On "Cementing in Surface or Drive Pipe as required by Rule 82-2-123 of the Commission for compliance with Sections 55-136, 55-137, and 55-138, 1947 Supplement to G. S. Kansas 1935")

Lease Owner Mid-Continent Petroleum Corp.

Office Address 512 Orpheum Bldg., Wichita, Kansas

Lease Name J. B. Cosman Well No. 2

Well Location (Example: C N/2 NE/4 NE/4 or footage from lines)

SEC C TWP NW RGE SW (E) (W) County Fawcett

Contractor Barnett Drilling, Inc.

Office Address 625 First National Bank Bldg., Wichita, Kansas

Drilled with (cable) (rotary) tools. Date pipe set 2-23-53

SURFACE HOLE DATA

SURFACE PIPE DATA

Size of Hole 13 3/4" Csg. (new) (used) Size 10 3/4" Wt 32.75#

Depth 990' Where set 990'

METHOD OF CEMENTING

(a) Cement: Amount and kind 500 sacks bulk cement

Method: (By Service Co., dump, tbg., etc.) Halliburton

Est. height cement behind pipe Circulated

(b) Cementing Material: Explain method. (Example: 8-5/8 w/ swage nipple run inside 15"; bridge hole w/ rock and hole filled with cementing material. 15" pipe pulled.)

Describe cementing material Bulk cement

GROUND WATER INFORMATION

Depth to bottom of lowest fresh water producing stratum 90'

Name of lowest fresh water producing stratum

Surface elevation of well Not known

ADDITIONAL INFORMATION

(Additional information may be submitted on separate sheet)

A F F I D A V I T

STATE OF Kansas, COUNTY OF Sedgewick, SS

I, P. L. Mankay of the Mid-Continent Petroleum Corp. being first duly sworn on oath, state and certify that the facts, statements and matters herein contained and that the same are true and correct.

Subscribed and sworn to before me this 26 day of February 1953

My Commission Expires: \_\_\_\_\_ Notary Public

RECEIVED  
STATE CORPORATION COMMISSION  
DEC 14 1973  
CONSERVATION DIVISION  
Wichita, Kansas