


WELL PLUGGING RECORD

Give All Information Completely
Make Required Affidavit
Mail or Deliver Report to:
Conservation Division
State Corporation Commission
800 Bitting Building
Wichita, Kansas

NORTH

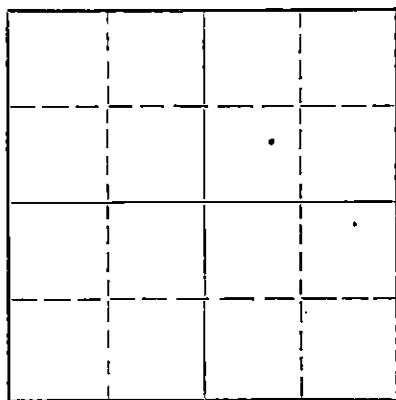

Locate well correctly on above
Section Plat

Pawnee County. Sec. 27 Twp. 21S Rge. (E) 16 (W)
Location as "NE/CNW/SW" or footage from lines NE SW NE Sec. 27-21-16W
Lease Owner Gulf Oil Corporation
Lease Name W. K. Bell Well No. 3
Office Address Box 661 Tulsa, Oklahoma
Character of Well (completed as Oil, Gas or Dry Hole) Lost Hole
Date well completed 6-27 1953
Application for plugging filed 6-27 1953
Application for plugging approved 6-27 1953
Plugging commenced 6-27 1953
Plugging completed 6-27 1953
Reason for abandonment of well or producing formation Stuck DP unable to recover

If a producing well is abandoned, date of last production - 19-
Was permission obtained from the Conservation Division or its agents before plugging was commenced? Yes

Name of Conservation Agent who supervised plugging of this well M. A. Rives
Producing formation Anhydrite Depth to top 978 Bottom 987 Total Depth of Well 987 Feet
Show depth and thickness of all water, oil and gas formations.

OIL, GAS OR WATER RECORDS

CASING RECORD

FORMATION	CONTENT	FROM	TO	SIZE	PUT IN	PULLED OUT
				NONE		

Describe in detail the manner in which the well was plugged, indicating where the mud fluid was placed and the method or methods used in introducing it into the hole. If cement or other plugs were used, state the character of same and depth placed, from _____ feet to _____ feet for each plug set.

Ran 6 jts. 8-5/8" casing and well started flowing from Dakota Section. Pulled 8-5/8" casing. Ran 4 1/2" DP to bottom. Attempted to kill water flow with mud, unsuccessful. Pulled DP up to 550' and pumped 322 sacks of Monarch Portland Bulk Cement thru DP by Halliburton. Killed water flow. Pulled DP up 65' and stuck. Unable to pull. Backed off at 320', leaving 165' in hole with top 320' from surface. Ran 4 1/2" DP to 413' and pumped 340 sacks Victor Portland cement, 3% gel, furnished by HOWCO, and filled hole to surface.

(If additional description is necessary, use BACK of this sheet)

Name of Plugging Contractor _____
Address _____

STATE OF Kansas COUNTY OF Rice, ss.
W. H. Duley (employee of owner) or (owner or operator) of the above-described well, being first duly sworn on oath, says: That I have knowledge of the facts, statements, and matters herein contained and the log of the above-described well as filed and that the same are true and correct. So help me God.

(Signature) W. H. Duley
Box 544 Phase, Kansas
(Address)

SUBSCRIBED AND SWORN to before me this 7 day of July, 1953

My commission expires April 24-1956

Howard Garrison
Notary Public.

PLUGGING
FILE SEC 27 T 21 R 16W
BOOK PAGE 111 LINE 23

RECEIVED
STATE CORPORATION COMMISSION
JUL 9 X 1953
CONSERVATION DIVISION
Wichita, Kansas