


WELL PLUGGING RECORD

Give All Information Completely
Make Required Affidavit
Mail or Deliver Report to:
Conservation Division
State Corporation Commission
211 No. Broadway
Wichita, Kansas

Pawnee County, Sec. 27 Twp. 21S Rge. 16W (E) (W) X

T - 21 NORTH R - 16W

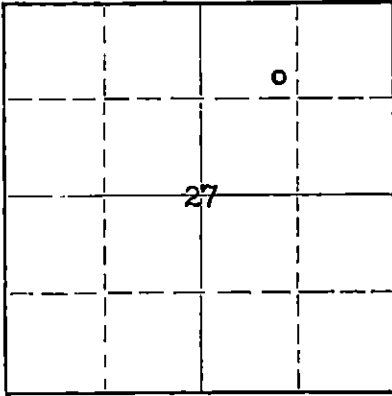

Locate well correctly on above Section Plat

Location as "NE/CNW/SW" or footage from lines SW- SE- NW- NE
Lease Owner Frank J. Black
Lease Name W. K. Bell Well No. 5
Office Address McPherson, Kansas
Character of Well (completed as Oil, Gas or Dry Hole) Oil
Date well completed 9-6 19 53
Application for plugging filed 9-28 19 61
Application for plugging approved 10-3 19 61
Plugging commenced 9-29 19 61
Plugging completed 10-11 19 61
Reason for abandonment of well or producing formation Non-commercial

If a producing well is abandoned, date of last production _____ 19____
Was permission obtained from the Conservation Division or its agents before plugging was commenced? Yes

Name of Conservation Agent who supervised plugging of this well Frank Broadfoot
Producing formation _____ Depth to top _____ Bottom _____ Total Depth of Well 3870 Feet
Show depth and thickness of all water, oil and gas formations.

OIL, GAS OR WATER RECORDS

CASING RECORD

FORMATION	CONTENT	FROM	TO	SIZE	PUT IN	PULLED OUT
				13"	106'	None
				8 5/8"	990'	None
				5 1/2"	3869'	3338'

Describe in detail the manner in which the well was plugged, indicating where the mud fluid was placed and the method or methods used in introducing it into the hole. If cement or other plugs were used, state the character of same and depth placed, from _____ feet to _____ feet for each plug set.

Sanded to 3855' - dumped 5 sks cement - pulled casing - mudded hole to 350' - set 10' rock bridge - dumped 20 sks cement - mudded hole to 35' - set 10' rock bridge - dumped 10 sks cement

RECEIVED
STATE CORPORATION COMMISSION
10-30-61
OCT 30 1961

CONSERVATION DIVISION
Wichita, Kansas

Name of Plugging Contractor R & D Casing Pulling Company License # 236
Address Box # 572, Hutchinson, Kansas

STATE OF KANSAS, COUNTY OF MCPHERSON, ss.
Frank J. Black (owner) of the above-described well, being first duly sworn on oath, says: That I have knowledge of the facts, statements, and matters herein contained and the log of the above-described well as filed and that the same are true and correct. So help me God.

(Signature) [Signature]
(Address) _____

SUBSCRIBED AND SWORN TO before me this 27th day of October, 1961

My commission expires July 16, 1963

Jerry Feitzman
JERRY FEITZMAN
Notary Public.

COPY

WELL LOG BUREAU—KANSAS GEOLOGICAL SOCIETY
508 East Murdock, Wichita, Kansas


15.145.00770.0000

Company- GULF OIL CORPORATION
Farm- W. K. Bell No. 5

SEC. 27 T. 21 R. 16W
SW SE NW NE
1650' NSL, 1910' WEL of NE/4

Total Depth. 3870
Comm. 8-17-53 Comp. 9-6-53
Shot or Treated.
Contractor.
Issued. 12-5-53

County Pawnee
KANSAS

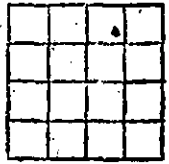

Elevation. 1985 DF

Production. 231 bbls. oil

CASING:

13" 106' cem./116 sx Left in 106'
8 5/8" 990' cem. w/450 sx Left in 990'
5 1/2" 3869' cem./w 50 sx Figures indicate Bottom of Formations.
Left in 3869'

sand	106
blue shale & shells	390
shale	415
sand	615
redbed & shells	940
redbed, shale	982
Anhydrite	1015
redbed, shells	1355
shale & shells	1810
lime & shale	3265
lime	3834
lime & shale	3868
dolomite	3870
Total depth	

Tops:	
Anhydrite	982
Heebner	3384
Toronto	3405
Brown lime	3484
Lansing	3494
Conglomerate	3765
Simpson	3809
Arbuckle	3868

Remarks:
Production: based on 8 hr. pumping test of 77 bbls.
Sand Record: Arbuckle 3868
Distance H: From top cellar to KB is 6'
Acidized w/300 gal. 9-4-53

RECEIVED
STATE CORPORATION COMMISSION
OCT 30 1961
CONSERVATION DIVISION
Wichita, Kansas