


STATE OF KANSAS
STATE CORPORATION COMMISSION

WELL PLUGGING RECORD

Give All Information Completely
Make Required Affidavit
Mail or Deliver Report to:
Conservation Division
State Corporation Commission
800 Bitting Building
Wichita, Kansas

Pawnee County, Sec. 27 Twp. 21S Rge. (E) 16 (W)
Location as "NE/CNW&SW¼" or footage from lines 990' E of WL, 580' N of SL, NW¼
Lease Owner SUNRAY OIL CORPORATION
Lease Name Robin Brown et al Well No. 1
Office Address Box 195, Great Bend, Kansas
Character of Well (completed as Oil, Gas or Dry Hole) Dry Hole
Date well completed August 23 19 53
Application for plugging filed August 24 19 53
Application for plugging approved August 25 19 53
Plugging commenced August 23 19 53
Plugging completed August 23 19 53
Reason for abandonment of well or producing formation Dry Hole

NORTH

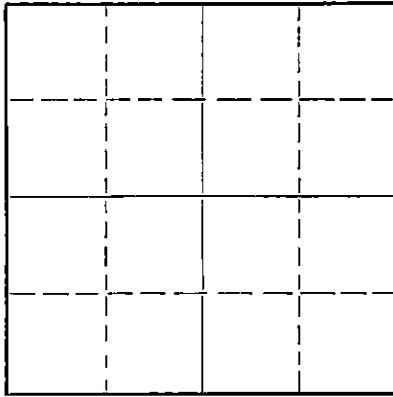

Locate well correctly on above
Section Plat

If a producing well is abandoned, date of last production 19
Was permission obtained from the Conservation Division or its agents before plugging was commenced? Yes

Name of Conservation Agent who supervised plugging of this well C. D. Strough, Great Bend, Kansas
Producing formation None Depth to top Bottom Total Depth of Well 3935 Feet
Show depth and thickness of all water, oil and gas formations.

OIL, GAS OR WATER RECORDS

CASING RECORD

FORMATION	CONTENT	FROM	TO	SIZE	PUT IN	PULLED OUT
Heebner		3408		8 5/8	995	none
Toronto		3424				
Brown Lime		3505				
Lansing-KC	Water	3514	3733			
Marmaton	Water	3774				
Conglomerate	Water	3784				

Describe in detail the manner in which the well was plugged, indicating where the mud fluid was placed and the method or methods used in introducing it into the hole. If cement or other plugs were used, state the character of same and depth placed, from feet to feet for each plug set.
Mudded hole to 300' and placed 30 sax cement. Mudded hole to 60' and placed 20 sax cement. Plugged under supervision of C. D. Strough, Commission representative.

Well log attached.

(If additional description is necessary, use BACK of this sheet)

Name of Plugging Contractor Stickle Drilling Company
Address Philtower Building, Tulsa, Oklahoma

STATE OF Kansas, COUNTY OF Barton, ss.
Robert K. Crouch (employee of owner) or (owner/operator) of the above-described well, being first duly sworn on oath, says: That I have knowledge of the facts, statements, and matters herein contained and the log of the above-described well as filed and that the same are true and correct. So help me God.

(Signature) Robert K. Crouch
Box 195, Great Bend, Kansas
(Address)

SUBSCRIBED AND SWORN to before me this 15th day of September, 1953

My commission expires December 24, 1956

Notary Public.

24-2675-5 2-52-20M
PLUGGING
FILE SEC 27 T 21 R 16W
BOOK PAGE 124 LINE 18

RECEIVED
STATE CORPORATION COMMISSION

SEP 16 1953

9-16-53

CONSULT

15.145.01058.0000

Sunray Oil Corporation
Tulsa, Oklahoma

Tulsa, Oklahoma
August 31, 1953

CONTRACTOR: Stickle Drilling Company
Drilling Commenced: August 9, 1953
Drilling Completed: August 23, 1953

Robin Brown etal #1
NW/4 Sec. 27-21S-16W
Pawnee County, Kansas.

DRILLERS LOG

Sand & Shale	0-282
Shale	282-430
Dakota Sand	430-520
Red Bed	520-986
Anhydrite	986-1025
Shale & Shells	1025-1715
Shale & Lime	1715-1800
Lime & Shale	1800-2095
Lime	2095-2115
Lime & Shale	2115-2205
Shale & Lime	2205-2305
Lime & Shale	2305-2670
Broken Lime & Shale	2670-2968
Lime & Shale	2968-3035
Lime	3035-3100
Lime & Shale	3100-3180
Lime	3180-3854
Conglomerate	3854-3895
Shale & Chert	3895-3925
Conglomerate	3925-3935 TD

I, Frank E. Stickle hereby certify the above to be a true and complete Drillers Log of Sunray Oil Corporation's Robin Brown etal #1 NW/4 Section 27-21S-16W, Pawnee County, Kansas.

Frank E. Stickle
Frank E. Stickle

Lillian T. Bonham
Notary Public

February 13, 1956

My Commission Expires

PLUGGING
FILE SEC 27 T 21 R 16W
BOOK PAGE 124 LINE 18

RECEIVED
STATE COMMISSIONER OF GEOL. & MINES
SEP 16 1956