


Give All Information Completely
Make Required Affidavit
Mail or Deliver Report to:
Conservation Division
State Corporation Commission
800 Bitting Building
Wichita, Kansas

WELL PLUGGING RECORD

NORTH

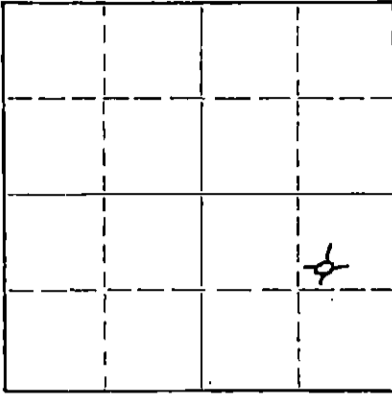

Locate well correctly on above
Section Plat

Pawnee County. Sec. 27 Twp. 21S Rge. (E) 16W
Location as "NE/CNW/SE" or footage from lines SW-NE-SE
Lease Owner Champlin Refining Company
Lease Name Miles Well No. 5
Office Address P.O. Dr. #552, Enid, Oklahoma
Character of Well (completed as Oil, Gas or Dry Hole) Dry Hole
Date well completed March 5, 1955
Application for plugging filed March 5, 1955
Application for plugging approved March 5, (Verbal) 1955
Plugging commenced March 6, 1955
Plugging completed March 6, 1955
Reason for abandonment of well or producing formation _____

If a producing well is abandoned, date of last production _____ 19____
Was permission obtained from the Conservation Division or its agents before plugging was commenced? Yes

Name of Conservation Agent who supervised plugging of this well M. A. Rives, Pratt, Kansas
Producing formation _____ Depth to top _____ Bottom _____ Total Depth of Well 3910 Feet
Show depth and thickness of all water, oil and gas formations.

OIL, GAS OR WATER RECORDS

CASING RECORD

FORMATION	CONTENT	FROM	TO	SIZE	PUT IN	PULLED OUT
				8 5/8" D	990'	None

Describe in detail the manner in which the well was plugged, indicating where the mud fluid was placed and the method or methods used in introducing it into the hole. If cement or other plugs were used, state the character of same and depth placed, from _____ feet to _____ feet for each plug set.

Filled hole from 3910' T.D. to 300' and pushed Wooden plug with drill pipe to 300' and filled hole from 300' to surface with cement using 100 sacks of Halliburton bulk cement.

STATE CORP. COM. 3-15 55
CONSERVATION DIVISION
Wichita, Kansas

(If additional description is necessary, use BACK of this sheet)
Name of Plugging Contractor Big Chief Drilling Company
Address Box 8837, Oklahoma City, Oklahoma

STATE OF Kansas, COUNTY OF Barton, ss.
J. W. Meyers (employee of owner) or (owner) of the above-described well, being first duly sworn on oath, says: That I have knowledge of the facts, statements, and matters herein contained and the log of the above-described well as filed and that the same are true and correct. So help me God.

(Signature) J. W. Meyers
P.O. Box 167, Ellinwood, Kansas
(Address)

SUBSCRIBED AND SWORN TO before me this 14th day of March, 1955

W. Kenneth Stearns
Notary Public.

My commission expires Sept. 10, 1955

PLUGGING
FILE SEC 27 T 21 R 16W
BOOK PAGE 102 LINE 33

TO KANSAS CORPORATION COMMISSION
 Conservation Division
 800 Bitting Building
 Wichita, Kansas

County Pawnee SEC. 27 TWP. 21S RGE. 16W

COMPANY OPERATING Champlin Refining Company

OFFICE ADDRESS P.O. Dr. #552, Enid, Oklahoma

FARM NAME Miles WELL NO. 5

WELL LOCATED 1650' from the South Line and 990' from
the East Line.

CHARACTER OF WELL Dry Hole

DRILLING COMMENCED February 21, 1955 DRILLING COMPLETED March 6, 1955

SIZE	WEIGHT	THDS	MAKE	FT.	AMOUNT PULLED	CEMENT
<u>8 5/8"</u>	<u>32#</u>	<u>8V</u>	<u>Used</u>	<u>989</u>		<u>500 Sx</u>

FORMATION RECORD

	TOPS	BOTTOM		TOPS	BOTTOM
	0'	40'	Surface Sand & Clay		
	40'	425'	Shale		
	425'	525'	Dakota Wtr. Sand.		
	525'	565'	Red Bed		
	565'	897'	Sand & Shale		
	897'	982'	Shale		
	982'	990'	Anhydrite		
	990'	1275'	Red Bed		
	1275'	1500'	Shale & Shells		
	1500'	1825'	Sandy, Shale & Shells		
	1825'	2000'	Shale, Lime		
	2000'	2150'	Lime		
	2150'	2205'	Shale & Lime		
	2205'	2226'	Fort Riley Lime		
	2226'	2486'	Lime		
	2486'	3190'	Shale & Lime		
	3190'	3425'	Lime		
	3425'	3514'	Lime, Shale		
	3514'	3565'	Shale & Lime		
	3565'	3611'	Lime & Sand		
	3611'	3662'	Lime		
	3662'	3763'	Shale & Lime		
	3763'	3820'	Lime		
	3820'	3860'	Shale & Lime		
	3860'	3910'	Lime		

RECEIVED
 STATE CORPORATION COMMISSION
 MAR 23 1955
 CONSERVATION DIVISION
 Wichita, Kansas

J. W. Myers
 Superintendent

N. Kenneth Stuebs
 Notary Public

Subscribed and sworn to before me
 this 21st day of March, 1955

My commission expires Sept. 10, 1955

PLUGGING
 FILE SEC 27 TWP 21S RGE 16W
 BOOK PAGE 102 LINE 33