


WELL PLUGGING RECORD

Give All Information Completely  
Make Required Affidavit  
Mail or Deliver Report to:  
Conservation Division  
State Corporation Commission  
800 Bittling Building  
Wichita, Kansas

NORTH

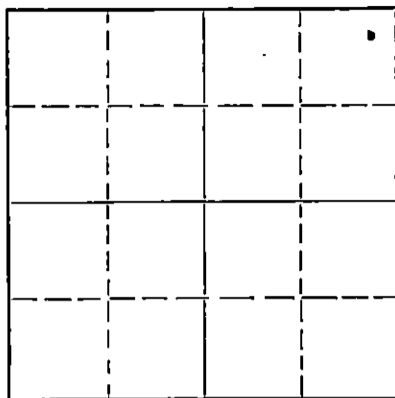

Locate well correctly on above Section Plat

Pawnee County. Sec. 27 Twp. 21S Rge. (E) 16 (W)  
Location as "NE/CNW/4SW/4" or footage from lines 330' W of EL, 330' S of NL of NE/4  
Lease Owner Gulf Oil Corporation  
Lease Name W. K. Bell Well No. 7  
Office Address Box 661 Tulsa, Oklahoma  
Character of Well (completed as Oil, Gas or Dry Hole) Lost Hole  
Date well completed 11-4 19 53  
Application for plugging filed 11-4 19 53  
Application for plugging approved 11-4 19 53  
Plugging commenced 11-4 19 53  
Plugging completed 11-4 19 53  
Reason for abandonment of well or producing formation Unable to fish drill collar at 165'  
If a producing well is abandoned, date of last production - 19 -  
Was permission obtained from the Conservation Division or its agents before plugging was commenced? Yes

Name of Conservation Agent who supervised plugging of this well M. A. Rives  
Producing formation \_\_\_\_\_ Depth to top \_\_\_\_\_ Bottom \_\_\_\_\_ Total Depth of Well 165 Feet  
Show depth and thickness of all water, oil and gas formations.

OIL, GAS OR WATER RECORDS

CASING RECORD

FORMATION	CONTENT	FROM	TO	SIZE	PUT IN	PULLED OUT
					None	

Describe in detail the manner in which the well was plugged, indicating where the mud fluid was placed and the method or methods used in introducing it into the hole. If cement or other plugs were used, state the character of same and depth placed, from \_\_\_\_\_ feet to \_\_\_\_\_ feet for each plug set.

Reamed 9" hole to 165' to 12 1/2". Unable to fish drill collar. Plugged hole w/225 sx. cement thru DP at 165'. Hole filled to top with cement.

RECEIVED  
NOV 13 1953  
CONSERVATION DIVISION  
WICHITA, KANSAS  
7-1-53

Name of Plugging Contractor \_\_\_\_\_  
Address \_\_\_\_\_

STATE OF Kansas, COUNTY OF Rice, ss.  
W. H. Duley (employee of owner) or (~~owner or operator~~) of the above-described well, being first duly sworn on oath, says: That I have knowledge of the facts, statements, and matters herein contained and the log of the above-described well as filed and that the same are true and correct. So help me God.

(Signature) W. H. Duley  
Box 544 Chase, Kansas  
(Address)

SUBSCRIBED AND SWORN TO before me this 5th day of November, 19 53

My commission expires April 14, 1956  
W. M. McConnell Notary Public.

**PLUGGING**  
FILE SEC 27-T-21-R/6w  
BOOK PAGE 141 LINE 13

