


STATE OF KANSAS
STATE CORPORATION COMMISSION

Form CP-4

WELL PLUGGING RECORD

Give All Information Completely
Make Required Affidavit
Mail or Deliver Report to:
Conservation Division
State Corporation Commission
P. O. Box 17027
Wichita, Kansas 67217
NORTH

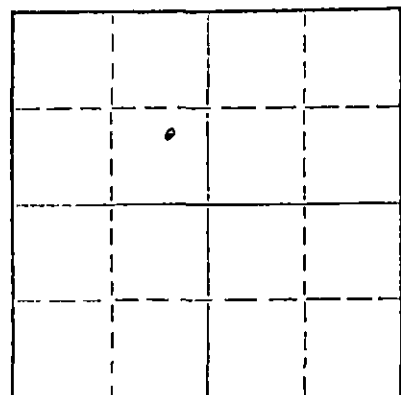

Locate well correctly on above
Section Plat

Pawnee County, Sec. 27 Twp. 21 Rge. (E) 16 (W)
Location as "NE/CNW/SW" or footage from lines 990' NSL 2310' EWL NW
Lease Owner Pipe Pullers, Inc.
Lease Name W. K. Bell Well No. 4
Office Address Box 486, Ellinwood, Kansas 67526
Character of Well (completed as Oil, Gas or Dry Hole) oil
Date well completed 19__
Application for plugging filed May 8 19 72
Application for plugging approved May 9 19 72
Plugging commenced May 8 19 72
Plugging completed May 17 19 72
Reason for abandonment of well or producing formation depleted

If a producing well is abandoned, date of last production 19__
Was permission obtained from the Conservation Division or its agents before plugging was commenced? yes

Name of Conservation Agent who supervised plugging of this well Leo Massey
Producing formation Depth to top Bottom Total Depth of Well 3870 Feet
Show depth and thickness of all water, oil and gas formations.

OIL, GAS OR WATER RECORDS

CASING RECORD

FORMATION	CONTENT	FROM	TO	SIZE	PUT IN	PULLED OUT
		0	992'	8 5/8"	992'	none
		0	3869'	5 1/2"	3869'	2015.84

Describe in detail the manner in which the well was plugged, indicating where the mud fluid was placed and the method or methods used in introducing it into the hole. If cement or other plugs were used, state the character of same and depth placed, from feet to feet for each plug set.

Sanded back to 3850' and dumped 5 sacks of cement.
Set rock bridge at 375'. Plugged well with 5 yards of ready mix cement.

RECEIVED
STATE CORPORATION COMMISSION
MAY 24 1972 5-24-72
CONSERVATION DIVISION
Wichita, Kansas

(If additional description is necessary, use BACK of this sheet)
Name of Plugging Contractor PIPE PULLERS, INC.
Address Box 486, Ellinwood, Kansas

STATE OF KANSAS COUNTY OF BARTON, ss.
Evelyn Roth

(employee of owner) or (owner or operator) of the above-described well, being first duly sworn on oath, says: That I have knowledge of the facts, statements, and matters herein contained and the log of the above-described well as filed and that the same are true and correct. So help me God.

(Signature) Evelyn Roth
Ellinwood, Kansas
(Address)

SUBSCRIBED AND SWORN TO before me this 23 day of May, 19 72

My commission expires Feb. 10, 1975

Serge A. Meyer
Notary Public

15.145.00769.0000

W. K. BRILL NO. 4
 990*NS1 2310' EWL NW SEC. 27-21S- 6W
 PAWNEE COUNTY, KANSAS
 JULF OIL CORPORATION

8-5/8" O. D. Casing Cemented at 992'
 5-1/2" O. D. Casing Cemented at 3869'

Drilling Commenced July 26, 1953
 Drilling Completed August 9, 1953

FROM	TO	FORMATION	REMARKS
00	75'	Sand	
75	125	Shale & shells	
125	520	Sand	
520	710	Shale, sand & red bed	
710	960	Red bed & shale (some pyrite)	
960	992	Shale & lime	8-5/8" O. D. casing cemented at 437 sacks of cement at 992'
992	1015	Anhydrite	
1015	1730	Shale & shells	
1730	2620	Shale & lime	
2620	2720	Shale	
2720	2830	Shale & lime	
2830	3065	Lime & shale	
3065	3405	Lime	
3405	3500	Lime & shale	
3500	3710	Lime	
3710	3816	Lime & shale	
3816	3865	Shale & lime	
3865	3870	Lime	5-1/2" O. D. casing cemented at 1100 sacks Portland cement at 3869'
3870	3870'		

RECEIVED
 STATE CORPORATION COMMISSION

MAY 9 - 1972

CONSERVATION DIVISION
 Wichita, Kansas