


STATE OF KANSAS
STATE CORPORATION COMMISSION

Form CP-4

WELL PLUGGING RECORD

Give All Information Completely
Make Required Affidavit
Mail or Deliver Report to:
Conservation Division
State Corporation Commission
P. O. Box 17027
Wichita, Kansas 67217
NORTH

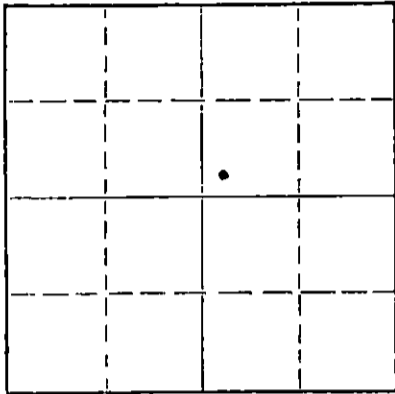

Locate well correctly on above
Section Plat

Pawnee County, Sec. 27 Twp. 21 Rge. (E) 16 (W)

Location as "NE/CNW/SW" or footage from lines SW SW NE
Lease Owner Pipe Pullers, Inc.
Lease Name W. K. Bell Well No. 2
Office Address Box 486, Ellinwood, Kansas 67526
Character of Well (completed as Oil, Gas or Dry Hole) oil
Date well completed 19__
Application for plugging filed May 24 19 72
Application for plugging approved May 25 19 72
Plugging commenced June 16 19 72
Plugging completed June 28 19 72
Reason for abandonment of well or producing formation depleted

If a producing well is abandoned, date of last production 19__
Was permission obtained from the Conservation Division or its agents before plugging was commenced? yes

Name of Conservation Agent who supervised plugging of this well Leo Massey
Producing formation _____ Depth to top _____ Bottom _____ Total Depth of Well 3864 Feet
Show depth and thickness of all water, oil and gas formations.

OIL, GAS OR WATER RECORDS

CASING RECORD

FORMATION	CONTENT	FROM	TO	SIZE	PUT IN	PULLED OUT
		0	985'	9 5/8"	985'	none
		0	3864'	7"	3864'	2019.89

Describe in detail the manner in which the well was plugged, indicating where the mud fluid was placed and the method or methods used in introducing it into the hole. If cement or other plugs were used, state the character of same and depth placed, from _____ feet to _____ feet for each plug set.

Sanded back to 3820' and dumped 6 sacks of cement.

Set bridge at 375'. Plugged well with 6 yards of ready mix cement.

RECEIVED
STATE CORPORATION COMMISSION
7-11-72 JUL 11 1972
CONSERVATION DIVISION
Wichita, Kansas

(If additional description is necessary, use BACK of this sheet)
Name of Plugging Contractor PIPE PULLERS, INC.
Address Box 486, Ellinwood, Kansas 67526

STATE OF KANSAS, COUNTY OF BARTON, ss.
Evelyn Roth (employee of owner) or (owner or operator) of the above-described well, being first duly sworn on oath, says: That I have knowledge of the facts, statements, and matters herein contained and the log of the above-described well as filed and that the same are true and correct. So help me God.

(Signature) Evelyn Roth
Ellinwood, Kansas
(Address)

SUBSCRIBED AND SWORN TO before me this 10th day of July, 19 72

My commission expires Aug. 20, 1975

[Signature]
Notary Public.

W. K. BELL NO. 2
CENTER SW SW NE SEC. 27-21S-16W
PAWNEE COUNTY, KANSAS
GULF OIL CORPORATION

9-5/8" O. D. casing cemented at 985'
7" O. D. casing cemented at 3864'

Drilling commenced May 23, 1953
Drilling completed June 6, 1953

FROM TO FORMATION REMARKS

0'	115'	Surface sand & clay
115	150	Shale & shells
150	200	Sand
200	415	Shale
415	520	Sand
520	680	Shale & red bed
680	880	Red bed & shale
880	980	Red bed
980	1035	Anhydrite
1035	1255	Shale & red bed
1255	1440	Shale & shells
1440	1500	Salt
1500	1810	Shale & shells
1810	2030	Shale & lime
2030	2295	Lime & shale
2295	2360	Lime
2360	2365	Lime & shale
2365	2495	Shale
2495	2630	Shale & shells
2630	2726	Shale & lime
2726	2885	Shale
2885	2960	Shale & lime
2960	3065	Lime & shale
3065	3395	Lime
3395	3482	Lime & shale
3482	3740	Lime
3740	3825	Lime & shale
3825	3856	Lime & shale (simpson sand)
3856	3864	Shale & Arbuckle Lime
T.D	3864'	

9-5/8" O. D. casing cemented with 550 sacks bulk cement at 985'

7" O. D. casing cemented with 100 sacks common cement at 3864'

RECEIVED
STATE CORPORATION COMMISSION
MAY 25 1972
CONSERVATION DIVISION
Wichita, Kansas