


STATE OF KANSAS  
STATE CORPORATION COMMISSION

Form CP-4

Give All Information Completely  
Make Required Affidavit  
Mail or Deliver Report to:  
Conservation Division  
State Corporation Commission  
P. O. Box 17027  
Wichita, Kansas 67217  
NORTH

WELL PLUGGING RECORD

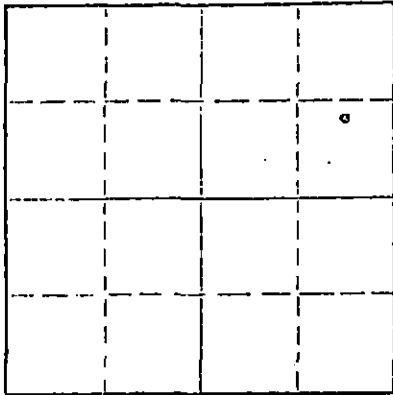

Locate well correctly on above  
Section Plat

Pawnee County, Sec. 27 Twp. 21 Rge. (E) 16 (W)  
Location as "NE/CNW/SE" or footage from lines. N/2 SE NE  
Lease Owner Pipe Pullers, Inc.  
Lease Name W. K. Bell Well No. 10  
Office Address Box 486, Ellinwood, Kansas 67526  
Character of Well (completed as Oil, Gas or Dry Hole) oil  
Date well completed \_\_\_\_\_ 19\_\_\_\_  
Application for plugging filed April 19 19 72  
Application for plugging approved April 20 19 72  
Plugging commenced May 17 19 72  
Plugging completed May 30 19 72  
Reason for abandonment of well or producing formation depleted

If a producing well is abandoned, date of last production \_\_\_\_\_ 19\_\_\_\_  
Was permission obtained from the Conservation Division or its agents before plugging was commenced? yes

Name of Conservation Agent who supervised plugging of this well Leo Massey  
Producing formation \_\_\_\_\_ Depth to top \_\_\_\_\_ Bottom \_\_\_\_\_ Total Depth of Well 3869 Feet  
Show depth and thickness of all water, oil and gas formations.

OIL, GAS OR WATER RECORDS

CASING RECORD

FORMATION	CONTENT	FROM	TO	SIZE	PUT IN	PULLED OUT
		0	983'	10 3/4"	983'	none
		0	3836'	7"	3836'	2032.23

Describe in detail the manner in which the well was plugged, indicating where the mud fluid was placed and the method or methods used in introducing it into the hole. If cement or other plugs were used, state the character of same and depth placed, from \_\_\_\_\_ feet to \_\_\_\_\_ feet for each plug set.

Sanded back to 3825' and dumped 6 sacks of cement.

Set 20' rock bridge at 375'. Plugged well with 6 yards of ready mix cement.

RECEIVED  
STATE CORPORATION COMMISSION  
JUN 6 1972  
CONSERVATION DIVISION  
Wichita, Kansas

Name of Plugging Contractor PIPE PULLERS, INC.  
Address Box 486, Ellinwood, Kansas 67526

STATE OF KANSAS COUNTY OF BARTON, ss.  
Evelyn Roth (employee of owner) or (owner or operator) of the above-described well, being first duly sworn on oath, says: That I have knowledge of the facts, statements, and matters herein contained and the log of the above-described well as filed and that the same are true and correct. So help me God.

(Signature) Evelyn Roth  
Ellinwood, Kansas  
(Address)

SUBSCRIBED AND SWORN TO before me this 5th day of June, 19 72

My commission expires Feb. 10, 1975

George A Meyer  
Notary Public.

15.145.00775.0000

W. K. BELL 10  
 CENTER N/2 SE NE SECTION 27-21S-16W  
 PAWNEE COUNTY, KANSAS  
 GULF OIL CORPORATION

10-3/4" O. D. casing cemented at 983'  
 7" O. D. casing cemented at 3836'

Drilling commenced April 16, 1954  
 Drilling completed April 30, 1954

FROM	TO	FORMATION	REMARKS
0'	135'	Sand	
135	420	Shale & shells	
420	518	Sand	
518	973	Red bed	
973	1010	Anhydrite	10-3/4" O. D. casing cemented with 700 sacks cement at 983'
1010	1885	Shale & shells	
1885	2040	Shale & lime	
2040	2240	Lime	
2240	2335	Lime & shale	
2335	2455	Shale & lime streaks	
2455	2555	Lime & shale	
2555	2650	Shale & lime	
2650	2710	Shale & lime streaks	
2710	2850	Shale	
2850	2940	Shale & lime	
2940	3040	Lime	
3040	3120	Lime & shale	
3120	3185	Shale & lime	
3185	3425	Lime	
3425	3492	Shale & lime	
3492	3735	Lime	
3735	3785	Lime & chert	
3785	3825	Lime & sand	
3825	3854	Shale & lime	
3854	3866	Shale & Simpson sand	
3866	3869	Lime (Arbuckle)	7" O. D. casing cemented with 100 sacks bulk cement at 3836'
T.D.	3869'		

RECEIVED  
 STATE CORPORATION COMMISSION  
 APR 20 1972  
 CONSERVATION DIVISION  
 Wichita, Kansas