


R

STATE OF KANSAS  
STATE CORPORATION COMMISSION

Form CP-4

WELL PLUGGING RECORD

Give All Information Completely  
Make Required Affidavit  
Mail or Deliver Report to:  
Conservation Division  
State Corporation Commission  
P. O. Box 17027  
Wichita, Kansas 67217  
NORTH

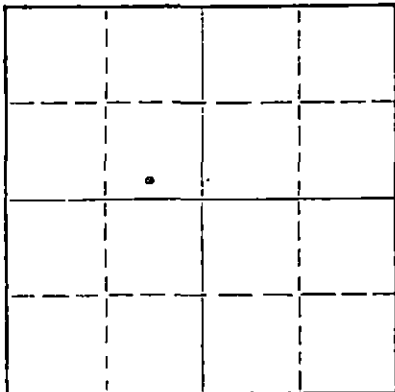

Locate well correctly on above  
Section Plat

Pawnee County, Sec. 27 Twp. 21 Rge. (E) 16 (W)  
Location as "NE/CNW/SW" or footage from lines S/2 SE NW  
Lease Owner Pipe Pullers, Inc.  
Lease Name W. K. Bell Well No. 1  
Office Address Box 486, Ellinwood, Kansas 67526  
Character of Well (completed as Oil, Gas or Dry Hole) oil  
Date well completed 19\_\_  
Application for plugging filed May 24 19 72  
Application for plugging approved May 25 19 72  
Plugging commenced June 5 19 72  
Plugging completed June 17 19 72  
Reason for abandonment of well or producing formation depleted

If a producing well is abandoned, date of last production: 19\_\_  
Was permission obtained from the Conservation Division or its agents before plugging was commenced? YES

Name of Conservation Agent who supervised plugging of this well Leo Massey  
Producing formation \_\_\_\_\_ Depth to top \_\_\_\_\_ Bottom \_\_\_\_\_ Total Depth of Well 3866 Feet  
Show depth and thickness of all water, oil and gas formations.

OIL, GAS OR WATER RECORDS

CASING RECORD

FORMATION	CONTENT	FROM	TO	SIZE	PUT IN	PULLED OUT
		0	992'	8 5/8"	992'	none
		0	3864'	5 1/2"	3864'	2876.60

Describe in detail the manner in which the well was plugged, indicating where the mud fluid was placed and the method or methods used in introducing it into the hole. If cement or other plugs were used, state the character of same and depth placed, from \_\_\_\_\_ feet to \_\_\_\_\_ feet for each plug set.

Sanded back to 3800' and dumped 5 sacks of cement.

Set plug at 375'. Plugged well with 5 yards of ready mix cement.

RECEIVED  
STATE CORPORATION COMMISSION  
JUN 22 1972  
CONSERVATION DIVISION  
Wichita, Kansas

(If additional description is necessary, use BACK of this sheet)  
Name of Plugging Contractor PIPE PULLERS, INC.  
Address Box 486, Ellinwood, Kansas

STATE OF KANSAS, COUNTY OF BARTON, ss.  
Evelyn Roth (employee of owner) or (owner or operator) of the above-described well, being first duly sworn on oath, says: That I have knowledge of the facts, statements, and matters herein contained and the log of the above-described well as filed and that the same are true and correct. So help me God.

(Signature) Evelyn Roth  
Ellinwood, Kansas  
(Address)

SUBSCRIBED AND SWORN to before me this 20th day of June, 1972

My commission expires Feb. 10, 1975

George A. Meyer  
Notary Public.

15.145.00766.0000

W. K. BELL NO. 1  
 S/2 SE NW SECTION 27-21S-16W  
 PAWNEE COUNTY, KANSAS  
 GULF OIL CORPORATION

8-5/8" O. D. casing cemented at 992'  
 5-1/2" O. D. casing cemented at 3864'

Drilling commenced May 9, 1953  
 Drilling completed May 21, 1953

FROM	TO	FORMATION	REMARKS
0'	110'	Surface soil and sand	
110	200	Shale	
200	405	Shale & shells	
405	618	Sand & shale	
618	988	Red bed	
988	1025	Anhydrite	8-5/8" O. D. casing cemented with 430 sacks bulk cement at 992'
1025	1425	Shale & shells	
1425	1675	Shale, shells & salt	
1675	1860	Shale & shells	
1860	2090	Shale & lime	
2090	2505	Lime & shale	
2505	2620	Shale & shells	
2620	2960	Shale	
2960	3090	Shale & lime	
3090	3355	Lime	
3355	3470	Shale & lime	
3470	3760	Lime	
3760	3845	Lime & shale	
3845	3862	Simpson shale	
3862	3866	Arbuckle lime	5-1/2" O. D. casing cemented with 100 sacks Portland cement at 3864'
T. D.	3866'		

RECEIVED  
 STATE CORPORATION COMMISSION  
 MAY 25 1972  
 CONSERVATION DIVISION  
 Wichita, Kansas