

STATE OF KANSAS
STATE CORPORATION COMMISSION

WELL PLUGGING RECORD


Give All Information Completely
Make Required Affidavit
Mail or Deliver Report to:
Conservation Division
State Corporation Commission
800 Bittling Building
Wichita, Kansas

OR

FORMATION PLUGGING RECORD

Strike out upper line
when reporting plug-
ging off formations.

Stafford County. Sec. 29 Twp. 21S Rge. 13 (E) (W)
Location as "NE 1/4 NW 1/4 SW 1/4" or footage from lines NW NW SE
Lease Owner Petroleum, Inc.
Lease Name Keller 'A'
Office Address 100 Derby Building, Wichita 2, Kansas
Character of Well (completed as Oil, Gas or Dry Hole) Dry Hole
Date well completed March 20, 19 50
Application for plugging filed April 14, 19 50
Application for plugging approved March 24, 19 50
Plugging commenced March 20, 19 50
Plugging completed March 20, 19 50
Reason for abandonment of well or producing formation Dry Hole

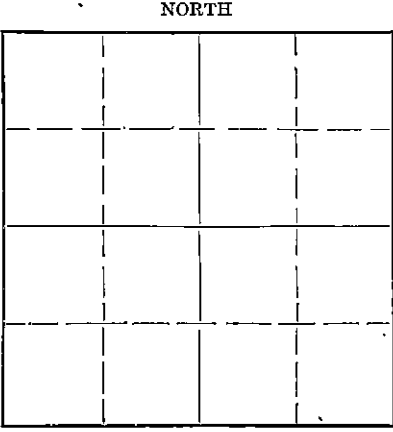

Locate well correctly on above
Section Plat

If a producing well is abandoned, date of last production 19
Was permission obtained from the Conservation Division or its agents before plugging was com-
menced? Yes

Name of Conservation Agent who supervised plugging of this well C. D. Stough, Box 207, Great Bend, Ks.
Producing formation Depth to top Bottom Total Depth of Well 3783 Feet
Show depth and thickness of all water, oil and gas formations.

OIL, GAS OR WATER RECORDS

CASING RECORD

Formation	Content	From	To	Size	Put In	Pulled Out
				8 5/8"	221.72'	

Describe in detail the manner in which the well was plugged, indicating where the mud fluid was placed and the method or methods used in introducing it into the hole. If cement or other plugs were used, state the character of same and depth placed, from feet to feet for each plug set.

Filled hole with heavy mud to 215 feet, set plug at 215 feet. Displaced through drill pipe 15 sacks cement @ 215'. Filled hole with heavy mud to 30 feet, set plug at 30 feet. Filled hole with cement to surface.

4-15-1950

(If additional description is necessary, use BACK of this sheet)

Correspondence regarding this well should be addressed to Petroleum, Inc.
Address 100 Derby Building, Wichita 2, Kansas


STATE OF KANSAS, COUNTY OF SEDGWICK, ss.
Eric H. Jager (employee of owner) of the above-described well,
being first duly sworn on oath, says: That I have knowledge of the facts, statements, and matters herein contained and the log of the above-described well as filed and that the same are true and correct. So help me God.

(Signature) Eric H. Jager
Executive Vice-President
100 Derby Building, Wichita, Kansas
(Address)

SUBSCRIBED AND SWORN to before me this 14th day of April, 1950.

Marjorie Bradshaw
Notary Public.

My commission expires October 27, 1952.

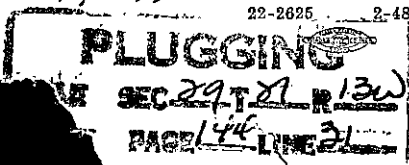

WELL LOG KELLER NO. 1

Petroleum, Inc., Lease Owner

Section 29, Twp. 21S, Rge. 13W

Drillers, Inc., Contractor

Location: NW NW SE

Rotary Total Depth: 3783'

County: Stafford, Kansas

Commenced: March 9, 1950
Completed: March 20, 1950

Production: Dry Hole

Casing: 221.72' of 8 5/8"

Elevation: 1926 D.F.

Figures below indicate bottom of formation:

	<u>Tops</u>	
165 Sand	810	Anhydrite
220 Shale & Shells	3267	Heebner
345 Sand	3288	Toronto
540 Red Bed	3396	Br. Lime
830 Anhydrite	3410	Lansing
1220 Shale & Shells	3622	B.K.C.
1720 Lime	3654	P.B.C.
2125 Lime & Shale	3685	Viola
3254 Lime	3731	Simpson
3300 Lime & Shale	3779	Arbuckle
3396 Shale		
3449 Lime		
3602 Shale		
3640 Lime		
3678 Lime & Shale		
3688 Conglomerate		
3735 Chert		
3768 Shale		
3783 Arb. Lime		
3783 R.T.D.		

I hereby certify that this is a true and correct log of the above mentioned well.

PETROLEUM, INC.

Eric H. Jager
Eric H. Jager

STATE OF KANSAS
SS.
SEDGWICK COUNTY

Subscribed to and sworn to before me, a Notary Public in said County and State this PLUGGING March, 1949.

FILE SEC. 29.1 & 1.13
BOOK PAGE 144 LINE 31

Margorie Bradshaw
Notary Public

My Commission expires: October 27, 1952.