

STATE OF KANSAS
STATE CORPORATION COMMISSION

WELL PLUGGING RECORD

Give All Information Completely
Make Required Affidavit
Mail or Deliver Report to:
Conservation Division
State Corporation Commission
800 Bitting Building
Wichita, Kansas

Stafford County, Sec 29 Twp. 21S Rge. 13 (E) W (W)

Location as "NE/CNW/SW" or footage from lines NE NW SW

Lease Owner Peel-Hardman Oil Producers

Lease Name Keller Well No. 1

Office Address P.O. Box 359, Hoisington, Kansas

Character of Well (completed as Oil, Gas or Dry Hole) Dry Hole

Date well completed Sept. 10 1953

Application for plugging filed Sept. 10 19 53

Application for plugging approved Sept. 10 19 53


Plugging commenced Sept. 10 19 53

Plugging completed Sept. 10 19 53

Reason for abandonment of well or producing formation Dry hole

If a producing well is abandoned, date of last production 19

Was permission obtained from the Conservation Division or its agents before plugging was commenced? Yes

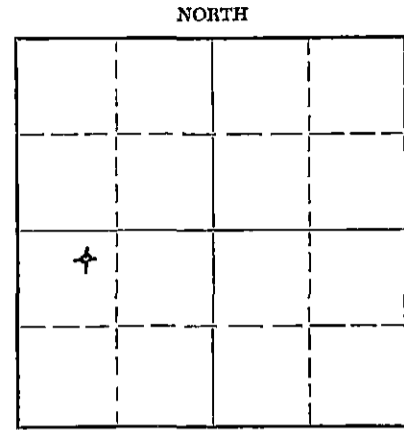

Locate well correctly on above
Section Plat

Name of Conservation Agent who supervised plugging of this well H. M. Rives

Producing formation _____ Depth to top _____ Bottom _____ Total Depth of Well 3760 Feet

Show depth and thickness of all water, oil and gas formations.

OIL, GAS OR WATER RECORDS

CASING RECORD

FORMATION	CONTENT	FROM	TO	SIZE	PUT IN	PULLED OUT
		0	325	8 5/8	325	None

Describe in detail the manner in which the well was plugged, indicating where the mud fluid was placed and the method or methods used in introducing it into the hole. If cement or other plugs were used, state the character of same and depth placed, from _____ feet to _____ feet for each plug set.

From 3760' to 271 1/2' - heavy rotary mud
 271 1/2' to 270' - wooden plug
 270' to 208' - 20 sacks cement
 208' to 41 1/2' - heavy rotary mud
 41 1/2' to 40' - wooden plug
 40' to 6' - 10 sacks cement
 6' to surface - cellar

9-15-1953

(If additional description is necessary, use BACK of this sheet)

Name of Plugging Contractor Glenn W. Peel
Address P.O. Box 359, Hoisington, Kansas

STATE OF KANSAS COUNTY OF BARTON, ss.
Glenn W. Peel (employee of owner) or (~~owner or operator~~) of the above-described well, being first duly sworn on oath, says: That I have knowledge of the facts, statements, and matters herein contained and the log of the above-described well as filed and that the same are true and correct. So help me God. GLENN W. PEEL

(Signature) [Signature] BY: [Signature]
P.O. BOX 359, Hoisington, Kansas
(Address)

SUBSCRIBED AND SWORN TO before me this 11th day of September, 19 53

My commission expires June 4, 1955 Marion M. Herbert Notary Public.

PLUGGING
FILE SEC 29 T 21 R 13W
BOOK 128 LINE 25

DRILLER'S LOG

Company: Peel-Hardman Oil Producers

NE NW SW
Sec. 29, Twp. 21S, Rge 13W,

Farm Name: Keller Well No. 1

County: Stafford,
Kansas

Total Depth: 3760'

Elevation:

Comm: 8-31-53 Comp: 9-10-53

Contractor: Glenn W. Peel

Production: *Dry*

Casing: 8 5/8" - 325' cem.

Figures below indicate bottoms of formations:

Top soils and water sands	0 -	100
Shale		250
Sand		295
Shale and Red Bed		635
Shale and Sand		1275
Shale and Shells		1665
Lime and Shale		1830
Sime and Shale streaks		1915
Lime and Shale		2150
Lime		2235
Lime and Shale		2565
Shale and Lime Streaks		2730
Shale and Lime		3135
Lime and Shale Streaks		3205
Lime		3685
Lime and Conglomerate		3760
Total Depth		3760

This is to certify that the above information is to the best of our knowledge, true and correct.

GLENN W. PEEL

BY: *Glenn W. Peel*

SUBSCRIBED AND SWORN to before me this 11th day of September, 1953.

My commission expires: June 4, 1955

Manaw M. Herbel
Notary Public

STATE OF KANSAS
CONSERVATOR OF WATER
Wichita, Kansas

PLUGGING
FILE SEC 29 T 21 R 13W
BOOK PAGE 128 LINE 25