


WELL PLUGGING RECORD

Give All Information Completely
Make Required Affidavit
Mail or Deliver Report to:
Conservation Division
State Corporation Commission
212 North Market, Insurance Bldg.
Wichita, Kansas

NORTH

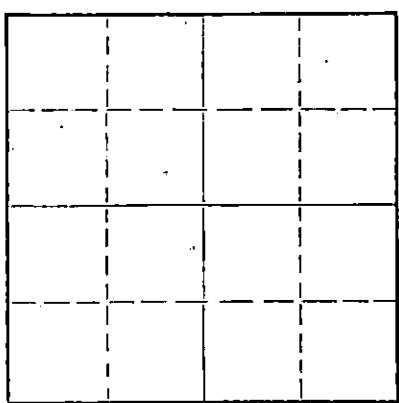

Locate well correctly on above
Section Plat

Stafford County. Sec. 29 Twp. 21 Rge. 13 (E) W (W)
Location as "NE/CNW%SW%" or footage from lines NE/4 SE/4 SW/4
Lease Owner Shields Oil Producers Inc.
Lease Name Shields Oil Producers-Keanan Well No. 1
Office Address Russell, Kansas.
Character of Well (completed as Oil, Gas or Dry Hole) Oil well
Date well completed August 30 19 56
Application for plugging filed April 19 19 60
Application for plugging approved April 20 19 60
Plugging commenced June 20 19 60
Plugging completed June 26 19 60
Reason for abandonment of well or producing formation Depleted

If a producing well is abandoned, date of last production April 19 60
Was permission obtained from the Conservation Division or its agents before plugging was commenced? yes.

Name of Conservation Agent who supervised plugging of this well Frank Broadfoot
Producing formation _____ Depth to top _____ Bottom _____ Total Depth of Well 3744 Feet
Show depth and thickness of all water, oil and gas formations.

OIL, GAS OR WATER RECORDS

CASING RECORD

FORMATION	CONTENT	FROM	TO	SIZE "	PUT IN	PULLED OUT
				8 5/8	242'	Cont'd w/ 200 pgs
				4 1/2"	3744'	2960'

Describe in detail the manner in which the well was plugged, indicating where the mud fluid was placed and the method or methods used in introducing it into the hole. If cement or other plugs were used, state the character of same and depth placed, from 3744 feet to surface feet for each plug set.
Hole filled with sand from 3744 to 3440. (Top perforation at 3455)
Four sacks of cement placed in bottom of hole with dump bailer
Halliburton pump trucks pumped down tank load of mud followed by
75 sacks of cement, following removal of 4 1/2 inch casing from hole
Plugging complete.

RECEIVED
STATE CORPORATION COMMISSION
JUL 25 1960
CONSERVATION DIVISION
Wichita, Kansas

Name of Plugging Contractor Barnes and Sons Pipe Pulling Co.
Address Russell, Kansas.

STATE OF Kansas, COUNTY OF Russell, ss.
Robert J. Shields (employee or owner) or (owner or operator) of the above-described well, being first duly sworn on oath, says: That I have knowledge of the facts, statements, and matters herein contained and the log of the above-described well as filed and that the same are true and correct. So help me God.

(Signature) Shields Oil Producers, Inc
Robert J. Shields, Pres.
Box 709 - Russell, Kansas
(Address)

SUBSCRIBED AND SWORN TO before me this 11th day of July 1960

Delphina A. Decker
Notary Public.

My commission expires November 9, 1963



Shields


Russell, Kansas

WELL LOG

15.185.01779.0000

Operator: Shields Oil Producers
 Well: Keenan # 1
 Commenced: August 20, 1956
 Completed: August 30, 1956
 Contractor: Shields Drilling Co., Inc.

Well Description: NE SE SW
 Sec. 29-21S-13W
 Stafford County, Kansas

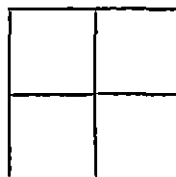

CASING RECORD		
Size	Run	Pulled
8 5/8"	242'	Cmtd w/ 200 sax
4 1/2"	3744'	Cmtd w/ 150 sax

Elevation: 1913 RB
 Treatment:
 Production:

Tops:		
Heebner		3236
Toronto		3256
Douglas		3271
Brown Lime		3365
Lansing-KC		3378
Conglomerate		3634
Viola		3643
Simpson Shale		3690
Arbuckle		3742

..... Figures Indicate Bottom of Formations

Sand & Shale	360
Shale & Red Bed	783
Anhydrite	812
Shale	1005
Shale & Shells	1390
Shale & Lime	1670
Lime & Shale	1855
Lime & Shale Streaks	1940
Lime & Chert	2060
Lime & Shale	2152
Lime	2300
Shale & Shells	2470
Shale & Lime Streaks	2760
Lime & Shale	2880
Lime & Shale Streaks	2965
Lime & Shale	3040
Lime	3220
Lime & Shale	3305
Lime	3690
Shale	3716
Lime	3746 RTD

RECEIVED
 STATE CORPORATION COMMISSION
 APR 20 1960
 CONSERVATION DIVISION
 Wichita, Kansas

Notes

- DST #1 3404-48 Tool open 1 hr. Weak blow for 8 minutes. Recovered 25' mud. BHP-310 # and still rising.
- DST #2 3448-70 Tool open 1 hr. Good blow. Recovered 160' clean oil, 60' muddy oil, 60' OCM and 60' OC muddy water. FFP-100 #, BHP-900#.