


Give All Information Completely  
Make Required Affidavit  
Mail or Deliver Report to:  
Conservation Division  
State Corporation Commission  
212 No. Market  
Wichita, Kansas

WELL PLUGGING RECORD

Stafford County, Sec. 29 Twp. 21 Rge. (E)13 (W)

Location as "NE/CNW%SW%" or footage from lines NE NE SE  
Lease Owner Petroleum, Inc.  
Lease Name Keller A #3 (Flood Unit #3-10) Well No. A #3  
Office Address 352 North Broadway, Wichita, Kansas  
Character of Well (completed as Oil, Gas or Dry Hole) oil  
Date well completed February 6 1952  
Application for plugging filed January 11 1966  
Application for plugging approved 19  
Plugging commenced January 12 1966  
Plugging completed January 25 1966  
Reason for abandonment of well or producing formation depleted

NORTH

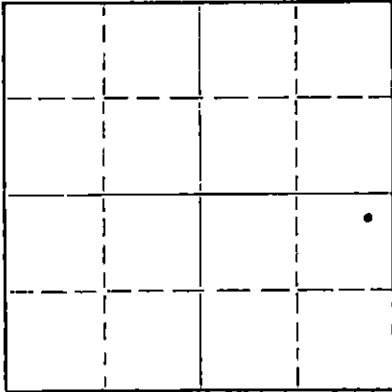

Locate well correctly on above  
Section Plat

If a producing well is abandoned, date of last production 19  
Was permission obtained from the Conservation Division or its agents before plugging was commenced? yes

Name of Conservation Agent who supervised plugging of this well Archie V. Elving  
Producing formation \_\_\_\_\_ Depth to top \_\_\_\_\_ Bottom \_\_\_\_\_ Total Depth of Well 3762 Feet  
Show depth and thickness of all water, oil and gas formations.

OIL, GAS OR WATER RECORDS

CASING RECORD

FORMATION	CONTENT	FROM	TO	SIZE	PUT IN	PULLED OUT
		0	205'	8 5/8"	205	none
		0	3761'	5 1/2"	3761	1812.40

Describe in detail the manner in which the well was plugged, indicating where the mud fluid was placed and the method or methods used in introducing it into the hole. If cement or other plugs were used, state the character of same and depth placed, from \_\_\_\_\_ feet to \_\_\_\_\_ feet for each plug set.

Pushed plug to 3380', set 10' rock bridge and dumped 5 sacks of cement.  
Pushed plug to 200' and dumped 10' of rock and 10 gallons of sand.  
Pumped 30 sacks of cement through 2" tubing. Bailed hole down to 40', set rock bridge and capped hole with 10 sacks of cement.

STATE CORPORATION COMMISSION

FEB 21 1966

CONSERVATION DIVISION  
WICHITA, KANSAS

(If additional description is necessary, use BACK of this sheet)

Name of Plugging Contractor Pipe Pullers, Inc.  
Address Box 486, Ellinwood, Kansas

STATE OF Kansas, COUNTY OF Barton, ss.  
Dean Wells (employee of owner) or (~~owner or operator~~) of the above-described

well, being first duly sworn on oath, says: That I have knowledge of the facts, statements, and matters herein contained and the log of the above-described well as filed and that the same are true and correct. So help me God.

(Signature) Dean Wells

Ellinwood, Kansas  
(Address)

SUBSCRIBED AND SWORN TO before me this 9th day of February, 1966

[Signature]  
Notary Public.

My commission expires July 7, 1967

15.185.01778.0000

WELL LOG BUREAU--KANSAS GEOLOGICAL SOCIETY  
508 East Murdock, Wichita, Kansas


COPY

Company- PETROLEUM INC.  
Farm- Keller "A" No. 3

SEC. 29 T. 21 R. 13W  
NE NE SE

Total Depth. 3762  
Comm. 1-26-52 Comp. 2-6-52  
Shot or Traced.  
Contractor. Garvey Drlg. Co.  
Issued. 4-26-52

County Stafford  
KANSAS

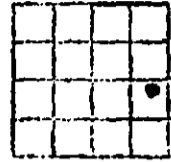

Elevation. 1909

Production. Pot. 40 BO & 2% wtr.

CASING:

8 5/8" 205' cem. w/225 sx  
5 1/2" 3761' cem. w/125 sx

Figures Indicate Bottom of Formations.

shale & shells	1610
shale & lime	2390
shale & shells	2855
lime & shale	3065
lime	3270
shale	3355
lime	3620
viola chert	3670
shale	3712
lime	3762 RTD
Total Depth	

Tops:	
Heebner	3225
Toronto	3245
Douglas	3261
Brown Lime	3351
Lansing	3363
Conglomerate	3616
Viola	3621
Simpson	3662
Arbuckle	3712

RECEIVED  
STATE CORPORATION COMMISSION

FEB 21 1966

CONSERVATION DIVISION  
Wichita, Kansas

DRILLER'S LOG KELLER 'A' #3

Petroleum, Inc., Lease Owner

Section 29, Twp. 21S, Rgs. 13W

Gervey Drilling Company, Contractor

Location: NE NE SE

Drilling Commenced: January 26, 1952

County: Stafford County

Drilling Completed: February 6, 1952

R.T.D. 3762'

Casing Records: 205' of 8 5/8" w/225 cas  
3761' of 5 1/2" w/125 casFigures below indicate bottom of formation:

1610 Shale & Shells  
2390 Shale & Lime  
2855 Shale & Shells  
3065 Lime & Shale  
3270 Lime  
3355 Shale  
3620 Lime  
3670 Viola Chert  
3712 Shale  
3762 Lime

## Tops:

Heabner: 3225 (-1316)  
Brown Lime: 3351 (-1442)  
Lensing: 3363 (-1454)  
Conglomerates: 3616 (-1707)  
Viola: 3621 (-1712)  
Simpson: 3662 (-1753)  
Arbuckles: 3712 (-1803)

3762' R.T.D.

I hereby certify that this is a true and correct log of the above mentioned well.

PETROLEUM, INC.

By Charlotte Steinman

STATE OF KANSAS )  
                          ) SS:  
COUNTY OF SEDGWICK )

Subscribed to and sworn to before me, a Notary Public, in said County and State, this 12th day of February, 1952.

Margaret Bradshaw  
Notary Public

My commission expires: October 27, 1952.

DRILLER'S LOG KELLER 'A' #3

Petroleum, Inc., Lease Owner	Section 29, Twp. 21S, Rge. 13W
Garvey Drilling Company, Contractor	Locations: NE NE SE
Drilling Commenced: January 26, 1952	County: Stafford County
Drilling Completed: February 6, 1952	R.T.D. 3762'
Casing Records: 205' of 8 5/8" w/225 sgs	
3761' of 5 1/8" w/125 sgs	

Figures below indicate bottom of formation:

1610	Shale & Shells	Tops:
2290	Shale & Lime	Heebner: 3225 (-1316)
2855	Shale & Shells	Brown Lime: 3351 (-1442)
3065	Lime & Shale	Lansing: 3363 (-1454)
3270	Lime	Conglomerates: 3616 (-1707)
3355	Shale	Viola: 3621 (-1712)
3620	Lime	Simpson: 3662 (-1753)
3670	Viola Chert	Arbuckle: 3712 (-1803)
3712	Shale	
3762	Lime	
3762'	R.T.D.	

I hereby certify that this is a true and correct log of the above mentioned well.

PETROLEUM, INC.

By *Charles W. ...*

STATE OF KANSAS )  
 ) SS:  
 COUNTY OF SEDGWICK )

Subscribed to and sworn to before me, a Notary Public, in said County and State, this 12th day of February, 1952.

*Marjorie Bradshaw*  
 Notary Public

My commission expires: October 27, 1952.