

STATE OF KANSAS
CORPORATION COMMISSION

WELL PLUGGING RECORD


Give All Information Completely
Make Required Affidavit
Mail or Deliver Report to:
Conservation Division
State Corporation Commission
800 Bittling Building
Wichita, Kansas

OR
FORMATION PLUGGING RECORD

Strike out upper line
when reporting plug-
ging off formations.

Stafford County. Sec. 21 Twp. 21 Rge. (E) 13 (W)

Location as "NE 1/4 NW 1/4 SW 1/4" or footage from lines
Lease Owner Chas. Hulme Drilling Contractor
Lease Name Sipes Well No. 1
Office Address P. O. Box 36, Great Bend, Kansas
Character of Well (completed as Oil, Gas or Dry Hole) Oil
Date well completed October 19 42
Application for plugging filed 11 - 14 19.50
Application for plugging approved 11 - 15 19.50
Plugging commenced 11 - 15 19.50
Plugging completed 11 - 25 19.50
Reason for abandonment of well or producing formation Would not produce
oil in commercial quantity
If a producing well is abandoned, date of last production February 19 48
Was permission obtained from the Conservation Division or its agents before plugging was com-
menced? Yes

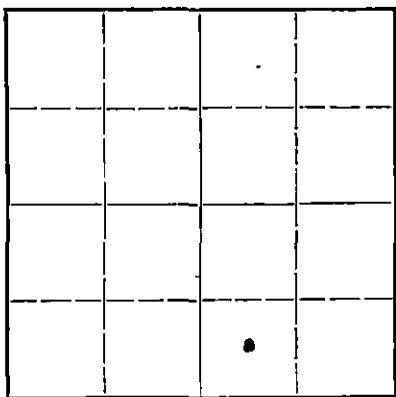

Locate well correctly on above
Section Plat

Name of Conservation Agent who supervised plugging of this well C. D. Stough
Producing formation Arbuckle Depth to top 3685' Bottom Total Depth of Well 3735 Feet
Show depth and thickness of all water, oil and gas formations.

OIL, GAS OR WATER RECORDS

CASING RECORD

Formation	Content	From	To	Size	Put In	Pulled Out
				8 5/8"	200'	
				5 1/2"	3685'	1872'

Describe in detail the manner in which the well was plugged, indicating where the mud fluid was placed and the method or methods used in introducing it into the hold. If cement or other plugs were used, state the character of same and depth placed, from.....feet to.....feet for each plug set.

Mudded hole. Pumped 100 sax of cement down surface casing W/Halliburton to shut off water flow as requested and supervised by Mr. C. D. Stough.

RECEIVED
STATE CORPORATION COMMISSION
NOV 30 1950
CONSERVATION DIVISION
Wichita, Kansas

(If additional description is necessary, use BACK of this sheet)

Correspondence regarding this well should be addressed to Chas. Hulme Drilling Contractor
Address P. O. Box 36, Great Bend, Kansas

STATE OF Kansas, COUNTY OF Barton, ss.
C. E. Byars (employee of owner) or (owner or operator) of the above-described well,

being first duly sworn on oath, says: That I have knowledge of the facts, statements, and matters herein contained and the log of the above-described well as filed and that the same are true and correct. So help me God.

(Signature) C. E. Byars
Great Bend, Kansas (Address)

SUBSCRIBED AND SWORN to before me this 27 day of November, 19 50

Notary Public.

My commission expires October 15, 1953


PLUGGING
FILE SEC 21 T 21 R 13 W
BOOK PAGE 48 LINE 43

SIMPSON OIL CO.-W.P.FAULKNER ET AL
 Sipes No. 1.

SEC.21 T.21 R.13 W
 CSW SE

Total Depth. 3693'
 Comm. 9-21-42 Comp. 10-28-42
 Shot or Treated.
 Contractor. Simpson & Noble, Inc.
 Issued. 11-21-42

County. Stafford

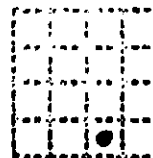

CASING:
 8 5/8" 200'
 5 1/2" 3685'

Elevation.

Production. Pot.1335 Plus
 101 BW

Figures Indicate Bottom of Formations.

sand	85
pyrites	105
grated sand	200
sand & shells	268
sand & shale	400
red & B. shale	680
shale & shells	1290
salt & shale	1477
shale & shells	1634
shale & lime brkn	1747
lime	1816
shale & shells	1954
lime & shale	2070
lime brkn	2110
shale	2190
lime brkn	2545
lime & shale	2640
lime brkn	2940
lime Topeka	3010
lime	3197
lime brkn	3280
lime	3355
lime Kansas City	3415
lime	3555
lime brkn & shale	3611
cherty shale	3642
lime brkn	3664
shale	3684
Arbuckle lime	3693
Total Depth.	

Top Kansas City lime 3341

PLUGGING
 FILE SEC 21 T 21 R 13W
 BOOK PAGE 42 LINE 43

RECEIVED
STATE CORPORATION COMMISSION

JAN 11 1951

CONSERVATION DIVISION
Wichita, Kansas