

WELL PLUGGING RECORD

Give All Information Completely
Make Required Affidavit
Mail or Deliver Report to:
Conservation Division
State Corporation Commission
800 Bitting Building
Wichita, Kansas

Stafford County. Sec. 21 Twp. 21 Rge. 13 (E) (W)

Location as "NE/CNW/SW" or footage from lines CE/2 W/2 SE/4

Lease Owner Chas. Hulme Drilling Contractor

Lease Name Sipes Well No. 2

Office Address P.O. Box 36, Great Bend, Kansas

Character of Well (completed as Oil, Gas or Dry Hole) Dry Hole

Date well completed October 27, 19 55

Application for plugging filed October 27, 19 55

Application for plugging approved October 27, 19 55


Plugging commenced October 27, 19 55

Plugging completed October 27, 19 55

Reason for abandonment of well or producing formation Dry Hole

If a producing well is abandoned, date of last production 19

Was permission obtained from the Conservation Division or its agents before plugging was commenced? Yes

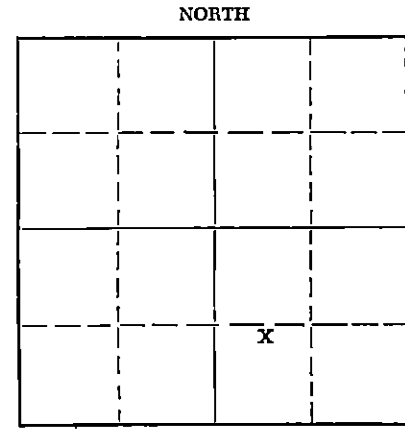

Locate well correctly on above Section Plat

Name of Conservation Agent who supervised plugging of this well Warren Horner

Producing formation Arbuckle Depth to top Bottom 3732 Total Depth of Well 3732 Feet

Show depth and thickness of all water, oil and gas formations.

OIL, GAS OR WATER RECORDS

CASING RECORD

FORMATION	CONTENT	FROM	TO	SIZE	PUT IN	PULLED OUT

Describe in detail the manner in which the well was plugged, indicating where the mud fluid was placed and the method or methods used in introducing it into the hole. If cement or other plugs were used, state the character of same and depth placed, from feet to feet for each plug set.

Plug set at 270 ft. - 20 sacks cement

270 Ft. to 230 Ft. - 10 sacks cement 35 Ft.

to surface

(If additional description is necessary, use BACK of this sheet)

Name of Plugging Contractor Chas. Hulme Drilling Contractor
Address P.O. Box 36, Great Bend, Kansas


STATE OF Kansas COUNTY OF Barton ss.
C. E. Byars (employee of owner) or (owner or operator) of the above-described

well, being first duly sworn on oath, says: That I have knowledge of the facts, statements, and matters herein contained and the log of the above-described well as filed and that the same are true and correct. So help me God.

(Signature) C. E. Byars
Great Bend, Kansas (Address)

SUBSCRIBED AND SWORN to before me this 2 day of November 19 55

My commission expires October 15, 1957 Notary Public.

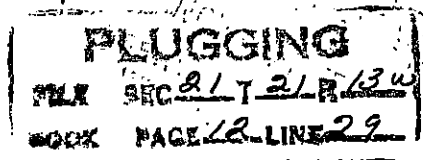

W E L L L O G

Company - Chas. Hulme Drilling Contractor Sec. 21-21S-13W
 Farm - Sipes No. 2 Location E/2 W/2 SE/4
 Total Depth - 3732'
 Comm. - October 18, 1955 Comp. - October 27, 1955
 Contractor - Chas. Hulme Drilling Contractor
 Casing - 268' 8-5/8" W/250 sacks cement
 Elevation - 1893' RB
 1888' GL

0	90	Sand	
90	100	Iron Streak	
100	255	Sand & Iron Streak	
255	268	Shale & Shells	
268	750	Shale	
750	925	Lime & Shale	
925	1170	Shale & Shells	
1170	1380	Salt	
1380	1640	Shale & Shells	
1640	1730	Lime & Shale	
1730	2090	Lime	
2090	2230	Shale & Shells	
2230	2705	Shale & Lime	
2705	3062	Lime	
3062	3100	Shale & Lime	
3100	3642	Lime	
3642	3732	Chert & Lime	
3732		T.D.	

	Tops:	
	Heebner:	3215'
	Brown Lime:	3345'
	Lansing:	3359'
	Viola:	3607'
	Simpson:	3714'

State of Kansas)
) ss:
 County of Barton)

I, C. E. Byars, of Chas. Hulme Drilling Company upon oath state that the above and foregoing is a true and correct copy of the log of the Sipes #2 well.

C. E. Byars

 C. E. Byars

Subscribed and sworn to before me this 2nd day of November, 1955

Felix Richardson

 Notary Public

My Commission Expires: October 15, 1957

PLUGGING
 P.L.R. SEC 21 T 21 R 13W
 PAGE 12 LINE 29

RECEIVED
 COMMISSION
 NOV - 4 - 1955
 DIVISION