


STATE OF KANSAS
STATE CORPORATION COMMISSION

WELL PLUGGING RECORD

Give All Information Completely
Make Required Affidavit
Mail or Deliver Report to:
Conservation Division
State Corporation Commission
800 Bittling Building
Wichita, Kansas

NORTH

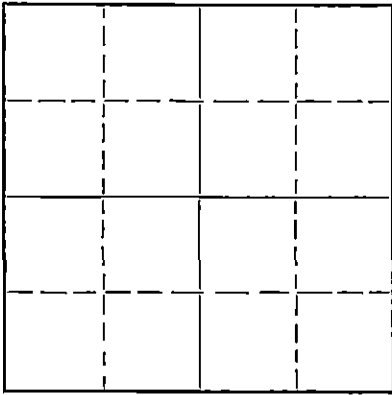

Locate well correctly on above
Section Plat

Stafford County, Sec. 21 Twp. 21 Rge. 13 (W)
Location as "NE/CNW $\frac{1}{4}$ SW $\frac{1}{4}$ " or footage from lines SE NE NW
Lease Owner Petroleum, Inc.
Lease Name Harter 'C' Well No. 1
Office Address 100 Derby Building, Wichita, Kansas
Character of Well (completed as Oil, Gas or Dry Hole) Dry Hole
Date well completed March 18, 19 51
Application for plugging filed March 18, 19 51
Application for plugging approved March 18, 19 51
Plugging commenced March 18, 19 51
Plugging completed March 18, 19 51
Reason for abandonment of well or producing formation Dry Hole

If a producing well is abandoned, date of last production 19
Was permission obtained from the Conservation Division or its agents before plugging was commenced? Yes

Name of Conservation Agent who supervised plugging of this well Mr. Charles Stough
Producing formation Depth to top Bottom Total Depth of Well 3734 Feet
Show depth and thickness of all water, oil and gas formations.

OIL, GAS OR WATER RECORDS

CASING RECORD

Formation	Content	From	To	Size	Put In	Pulled Out
				8 5/8"	226'	None

Describe in detail the manner in which the well was plugged, indicating where the mud fluid was placed and the method or methods used in introducing it into the hole. If cement or other plugs were used, state the character of same and depth placed, from feet to feet for each plug set.

Wooden plug set at 215'. Cemented and displaced through drill pipe 15 sax. Filled hole with heavy mud to 40'. Placed wooden plug at 40'. Filled hole to bottom of cellar with 10 sax cement.

RECEIVED
STATE CORPORATION COMMISSION
MAR 22 1951 3-22-1951
CONSERVATION DIVISION
WICHITA, KANSAS

(If additional description is necessary, use BACK of this sheet)
Correspondence regarding this well should be addressed to Petroleum, Inc.
Address 100 Derby Building, Wichita, Kansas

STATE OF KANSAS, COUNTY OF SEDGWICK, ss.
W. W. Fisher (employee of owner) of the above-described well,

being first duly sworn on oath, says: That I have knowledge of the facts, statements, and matters herein contained and the log of the above-described well as filed and that the same are true and correct. So help me God.

(Signature) W.W. Fisher
100 Derby Building, Wichita 2, Kansas (Address)

SUBSCRIBED AND SWORN TO before me this 21st day of March 19 51
Charlotte Hedman
Notary Public.

My commission expires October 13, 1954

PLUGGING
FILE SEC 21 T 21 R 13W
BOOK PAGE 68 (100)

15.185.11702.0000

WELL LOG HARTER 'C' #1

Petroleum, Inc., Lease Owner

Section 21, Twp. 21S, Rge. 13W

Garvey Oil, Contractor

Location: SE NE NW

Rotary Total Depth: 3734'

County: Stafford

Commenced: March 7, 1951

Production: D & A

Completed: March 18, 1951

Elevation: 1901 R.B.

Casing: 226' of 8 5/8"

Figures below indicate bottom of formation:

67	Surface clay & Sand		
100	Sandstone		
240	Shale & Shells	3225	- Heebner
300	Sand	3350	- Brown Lime
385	Shale & Sand	3365	- Lansing
767	Red Bed	3586	- B.K.C.
795	Anhydrite	3623	- Conglomerate
1125	Shale & Shells	3634	- Viola
1594	Shale	3684	- Simpson
2110	Lime & Shale		
2285	Shale & Shells		
2495	Shale		
2785	Shale & Shells		
2865	Shale		
2995	Lime & Shale		
3160	Lime		
3205	Lime & Shale		
3629	Lime		
3687	Lime & Shale		
3734'	Lime		

3734' R.T.D.

I hereby certify that this is a true and correct log of the above mentioned well.

PETROLEUM, INC.

STATE OF KANSAS:

SEDGWICK COUNTY:

RECEIVED *W W Fisher*
 STATE CORPORATION COMMISSION W. W. Fisher
PLUGGING
 FILE SEC *218* *130* 1951
 DIVISION
 BOOK PAGE *68* LINE *21* Kansas

Subscribed to and sworn to before me, a Notary Public in said County and State this 21st day of March, 1951.

Charlotte Hedman
Notary Public

My commission expires: 10-13-54