

STATE OF KANSAS  
STATE CORPORATION COMMISSION

Form CP-4

Give All Information Completely  
Make Required Affidavit  
Mail or Deliver Report to:  
Conservation Division  
State Corporation Commission  
212 No. Market  
Wichita, Kansas

WELL PLUGGING RECORD

Stafford County, Sec. 21 Twp. 21S Rge. (E) 13(W)

Location as "NE/CNW/SW" or footage from lines NE SW NW

Lease Owner Aspen Drilling Co.

Lease Name Harter Well No. 1

Office Address P.O. Box 783, Great Bend, Kansas

Character of Well (completed as Oil, Gas or Dry Hole) Dry Hole

Date well completed June 27 1968

Application for plugging filed June 27 1968

Application for plugging approved same 19  


Plugging commenced same 19  

Plugging completed same 19  

Reason for abandonment of well or producing formation dry hole

If a producing well is abandoned, date of last production    19  

Was permission obtained from the Conservation Division or its agents before plugging was commenced? yes

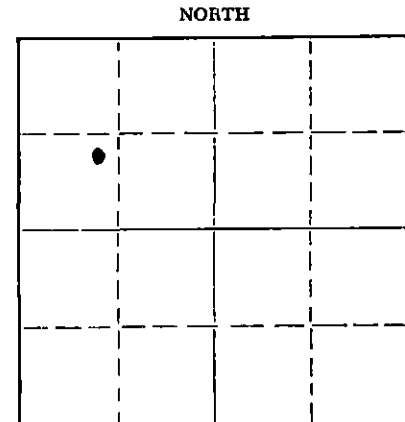

Locate well correctly on above Section Plat

Name of Conservation Agent who supervised plugging of this well Ralph J. Warren

Producing formation    Depth to top    Bottom    Total Depth of Well 3759 Feet

Show depth and thickness of all water, oil and gas formations.

OIL, GAS OR WATER RECORDS

CASING RECORD

FORMATION	CONTENT	FROM	TO	SIZE	PUT IN	PULLED OUT

Describe in detail the manner in which the well was plugged, indicating where the mud fluid was placed and the method or methods used in introducing it into the hole. If cement or other plugs were used, state the character of same and depth placed, from    feet to    feet for each plug set.

Wood plug and 25 sacks cement at 300'.  
Mud to 40', wood plug, 1/4 sack hulls and 10 sacks cement.  
2 sacks cement in rat hole.

RECEIVED  
STATE CORPORATION COMMISSION  
JUL 11 1968  
CONSERVATION DIVISION  
Wichita, Kansas

(If additional description is necessary, use BACK of this sheet)  
Name of Plugging Contractor Company tools  
Address   


STATE OF Kansas, COUNTY OF Barton, ss.

Jack Dunham (employee of owner) or (owner or operator) of the above-described well, being first duly sworn on oath, says: That I have knowledge of the facts, statements, and matters herein contained and the log of the above described well as filed and that the same are true and correct. So help me God.

(Signature) Jack Dunham

P. O. Box 783, Great Bend, Kansas  
(Address)

Subscribed and sworn to before me this 28th day of June, 1968

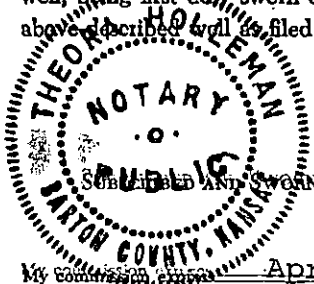

Theora Holleman  
Notary Public.

My Commission Expires April 18, 1972

DRILLERS LOG

COMPANY: Aspen Drilling Co.  
 CONTRACTOR: Aspen Drilling Co.  
 LEASE NAME: Harter #1  
 LOCATION: NE SW NW Sec.21-T21S-R13W  
 Stafford County, Kansas  
 ELEVATION: 1916 KB  
 SURFACE CASING: 8 jts.(320') 8 5/8"  
 COMMENCED: 6-20-68  
 COMPLETED: 6-27-68  
 ROTARY TOTAL DEPTH: 3759'

<u>FORMATION</u>	<u>DEPTH</u>	
Shale & Red Bed	787	Ran 8 jts.(320') 8 5/8" casing,
Anhydrite	820	set at 328', cemented with 250
Shale	1560	sacks cement. Cement circulated.
Shale-Shells	1655	
Lime-Shale	2300	DST #1 3660-3693
Shale-Lime	3057	DST #2 3684-3759
Lime	3264	
Shale-Lime	3380	Ran electric log.
Lime	3615	
Lime & Chert	3693	
Lime	3740	
Arbuckle	3759	

LOG TOPS

Anhydrite	787
Base Anhydrite	809
Heebner	3256
Toronto	3276
Douglas	3290
Brown Lime	3381
Lansing	3395
Base KC	3619
Conglomerate	3641
Viola	3652
Simpson	3689
Arbuckle	3739
Log TD	3959

STATE OF KANSAS  
 JUL 1 1968  
 CONSERVATION DIVISION  
 Wichita, Kansas


AFFIDAVIT

State of Kansas )  
 ) ss:  
 County of Barton )

The undersigned, being duly sworn on oath, states that the above statement and log are a true and correct record and log of the well drilled at the location above described.

*William S. Schachle*  
 William S. Schachle

Subscribed and sworn to before me this 1st day of July, 1968.

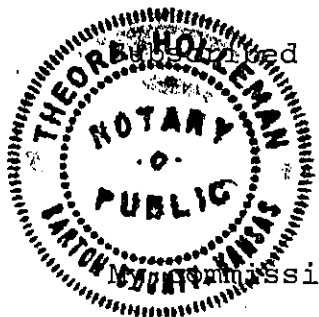

*Theora Holleman*  
 Theora Holleman  
 Notary Public

My Commission expires: April 18, 1972