


WELL PLUGGING RECORD

Give All Information Completely
Make Required Affidavit
Mail or Deliver Report to:
Conservation Division
State Corporation Commission
211 No. Broadway
Wichita, Kansas

Stafford County, Sec. 21 Twp. 21S Rge. (E) 13 (W)

Location as "NE/CNW/SW" or footage from lines SE/4 SW/4
Lease Owner Frank J. Black
Lease Name Hazel Ward Well No. 1
Office Address McPherson, Kansas
Character of Well (completed as Oil, Gas or Dry Hole) Oil
Date well completed 6-29 1942
Application for plugging filed 12-22 1961
Application for plugging approved 12-26 1961
Plugging commenced 12-26 1961
Plugging completed XX 1-3 1962
Reason for abandonment of well or producing formation Non-commercial

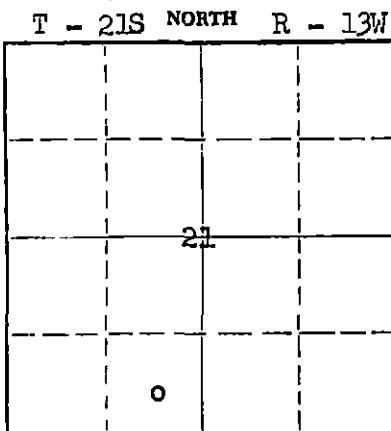

Locate well correctly on above Section Plat

If a producing well is abandoned, date of last production 19
Was permission obtained from the Conservation Division or its agents before plugging was commenced? Yes

Name of Conservation Agent who supervised plugging of this well W. L. Lackamp, Jr.
Producing formation _____ Depth to top _____ Bottom _____ Total Depth of Well 3738 Feet
Show depth and thickness of all water, oil and gas formations.

OIL, GAS OR WATER RECORDS

CASING RECORD

FORMATION	CONTENT	FROM	TO	SIZE	PUT IN	PULLED OUT
				8 5/8"	224'	None
				5 1/2"	3730'	2645'

Describe in detail the manner in which the well was plugged, indicating where the mud fluid was placed and the method or methods used in introducing it into the hole. If cement or other plugs were used, state the character of same and depth placed, from _____ feet to _____ feet for each plug set.

Plug @ 2640'

Dumped half yard sand and 5 sks cement - pulled casing - mudded hole to 200' - set 10' rock bridge - 1 sks Calseal - dumped 20 sks cement - mudded hole to 30' - set 10' rock bridge - dumped 10 sks cement

RECEIVED
STATE CORPORATION COMMISSION

FEB 8 1962

CONSERVATION DIVISION
Wichita, Kansas

2-8-1962

(If additional description is necessary, use BACK of this sheet)
Name of Plugging Contractor R & D Casing Pulling Company License # 236
Address Box # 572, Hutchinson, Kansas

STATE OF KANSAS, COUNTY OF MCPHERSON, ss.
Frank J. Black (owner)

well, being first duly sworn on oath, says: That I have knowledge of the facts, statements, and matters herein contained and the log of the above-described well as filed and that the same are true and correct. So help me God.

(Signature) _____
(Address) _____

SUBSCRIBED AND SWORN TO before me this 6th day of February, 1962

My commission expires July 16, 1963
JERRY PELTZMAN Notary Public

COPY


W. P. FAULKNER
 Ward No. 1.

SEC.21 T.21 R.13 W
 CE $\frac{1}{2}$ SE SW

DISCOVERY WELL

Total Depth. 3703'
 Comm. 5-30-42 Comp. 6-29-42
 Shot or Treated.
 Contractor. Simpson & Noble, Inc.
 Issued. 11-21-42

County. Stafford

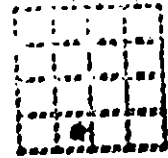

CASING:
 8 5/8" 224'
 5 1/2" 3693'

Elevation.

Production. Pot.8444 B.

Figures Indicate Bottom of Formations.

sand & clay	95
sand rock hd	121
shale & shells	200
shale blue	245
sand	270
shale & shells	385
red bed	782
anhydrite	835
shale & shells	1250
salt & shale	1540
shale & shells	2170
lime brkn	2190
lime	2260
lime brkn	2280
lime	2331
lime brkn	2712
shale	2730
lime brkn	2919
lime	2976
lime brkn Topeka	3150
lime brkn	3292
shale	3344
lime	3480
lime brkn, chert, Kansas City	3485
lime	3535
lime brkn	3574
lime	3620
lime brkn	3635
chert brkn	3640
shale	3692
lime Arbuckle	3703
Total Depth.	

RECEIVED
 STATE CORPORATION COMMISSION
 FEB 8 1962
 CONSERVATION DIVISION