

STATE OF KANSAS
STATE CORPORATION COMMISSION


Form CP-4

Give All Information Completely
Make Required Affidavit
Mail or Deliver Report to:
Conservation Division
State Corporation Commission
212 No. Market
Wichita, Kansas 67202

WELL PLUGGING RECORD

Stafford County, Sec. 21 Twp. 21 Rge. (E) 13 (W)

Location as "NE/CNWxSWx" or footage from lines CS/2 SE SW
Lease Owner Harms Petroleum Company
Lease Name Harms "C" Well No. 1
Office Address Box 488, Great Bend, Kansas 67530
Character of Well (completed as Oil, Gas or Dry Hole) oil
Date well completed _____ 19____
Application for plugging filed January 23 1970
Application for plugging approved _____ 19____
Plugging commenced February 7 1970
Plugging completed February 14 1970
Reason for abandonment of well or producing formation depleted

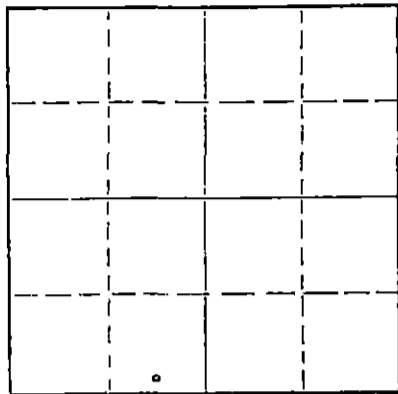

Locate well correctly on above Section Plat

If a producing well is abandoned, date of last production _____ 19____
Was permission obtained from the Conservation Division or its agents before plugging was commenced? YES

Name of Conservation Agent who supervised plugging of this well Ralph Warren
Producing formation _____ Depth to top _____ Bottom _____ Total Depth of Well 3712 Feet
Show depth and thickness of all water, oil and gas formations.

OIL, GAS OR WATER RECORDS

CASING RECORD

FORMATION	CONTENT	FROM	TO	SIZE	PUT IN	PULLED OUT
		0	301'	8 5/8"	301'	none
		0	3707'	4 1/2"	3707'	260.38

Describe in detail the manner in which the well was plugged, indicating where the mud fluid was placed and the method or methods used in introducing it into the hole. If cement or other plugs were used, state the character of same and depth placed, from _____ feet to _____ feet for each plug set.

Sanded back to 3675' and dumped 4 sacks of cement.

Squeezed well with 15 sacks mud and 90 sacks of cement.

RECEIVED
STATE CORPORATION COMMISSION
FEB 24 1970
CONSERVATION DIVISION
Wichita, Kansas

(If additional description is necessary, use BACK of this sheet)
Name of Plugging Contractor PIPE PULLERS, INC.
Address Box 486, Ellinwood, Kansas

STATE OF Kansas, COUNTY OF Barton, ss.
Evelyn Roth (employee of owner) or (owner or operator) of the above-described well, being first duly sworn on oath, says: That I have knowledge of the facts, statements, and matters herein contained and the log of the above-described well as filed and that the same are true and correct. So help me God.

(Signature) Evelyn Roth
Ellinwood, Kansas (Address)

SUBSCRIBED AND SWORN TO before me this 23 day of February 1970

My commission expires Feb. 10, 1971
George A. Meyer Notary Public.

15.185.19524.0000

KANSAS GEOLOGICAL SOCIETY
KANSAS WELL LOG BUREAU - KANSAS WELL SAMPLE BUREAU
KANSAS GEOLOGICAL SOCIETY BUILDING
508 EAST MURDOCK - WICHITA, KANSAS

COPY

COMPANY HARMS PET. CO.

SEC. 21 T. 21 R. 13W
LOC. CS/2 SE SW

FARM Harms 'C' NO. 1

TOTAL DEPTH 3712

COUNTY Stafford
KANSAS


COMM. 7-15-64

COMP. 8-27-64

SHOT OR TREATED

CONTRACTOR Harms Pet. Co.

ISSUED 11-26-66

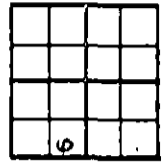

CASING

20	10	
15	8 5/8	301' w/250 sx cem.
12	6	
13	5 4	3707'

ELEVATION 1920' K.B.

PRODUCTION Pmp. 40 BOPD

FIGURES INDICATE BOTTOM OF FORMATIONS

(Arb 3707-12)

COMPLETE DRILLERS LOG NOT AVAILABLE.

TOPS: SCOUT	SAMPLE
Heebner	3233
Toronto	3254
Douglas	3296
Brown Lime	3361
Lansing	3374
B/Kansas City	3564
Conglomerate	3612
Viola	3624
Simpson	3668
Arbuckle	3706

RECEIVED
STATE CORPORATION COMMISSION
JAN 26 1970
CONSERVATION DIVISION
Wichita, Kansas