


WELL PLUGGING RECORD

Give All Information Completely  
Make Required Affidavit  
Mail or Deliver Report to:  
Conservation Division  
State Corporation Commission  
212 North Market, Insurance Bldg.  
Wichita, Kansas

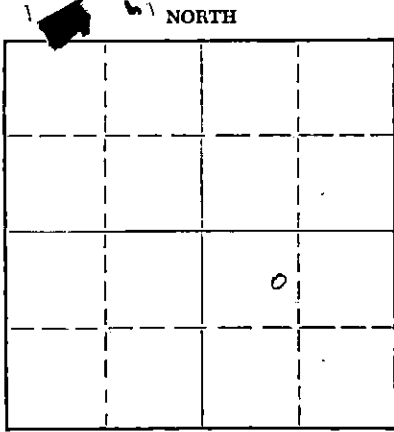

Locate well correctly on above Section Plat

Stafford County. Sec. 21 Twp. 21 Rge. 13 (E) W (W)  
Location as "NE/CNW/SW" or footage from lines CE/2 NW SE  
Lease Owner Lawrence Supply Co., Inc.  
Lease Name Sipes "B" #1 Well No.  
Office Address Great Bend, Kansas  
Character of Well (completed as Oil, Gas or Dry Hole)  
Date well completed 19  
Application for plugging filed 19  
Application for plugging approved 19  
Plugging commenced 3-11-59 19  
Plugging completed 3-16-59 19  
Reason for abandonment of well or producing formation

If a producing well is abandoned, date of last production 19  
Was permission obtained from the Conservation Division or its agents before plugging was commenced? YES

Name of Conservation Agent who supervised plugging of this well Frank Broadfoot  
Producing formation Depth to top Bottom Total Depth of Well 3692 Feet  
Show depth and thickness of all water, oil and gas formations.

OIL, GAS OR WATER RECORDS

CASING RECORD

FORMATION	CONTENT	FROM	TO	SIZE	PUT IN	PULLED OUT
				8-5/8"	278'	none
				5-1/2"	3681'	3064'

Describe in detail the manner in which the well was plugged, indicating where the mud fluid was placed and the method or methods used in introducing it into the hole. If cement or other plugs were used, state the character of same and depth placed, from feet to feet for each plug set.

Checked the hole to 3692' and found it open.  
Filled w/sand to 3670' and ran 5 sacks of cement with bailer. Pulled 5 1/2" casing, tried to bail hole, but could not. Pushed plug to 250', put in 10' rock bridge and ran 2 sacks of cal-seal on bridge, let cal-seal set up, and bailed hole dry and ran 25 sacks of cement at 240'. Mudded the hole to 40', set rock bridge and ran 15 sacks of cement to base of cellar.

PLUGGING COMPLETED

RECEIVED  
STATE CORPORATION COMMISSION  
MAR 24 1959  
CONSERVATION DIVISION  
Wichita, Kansas

(If additional description is necessary, use BACK of this sheet)

Name of Plugging Contractor West Supply Co., Inc.  
Address Chase, Kansas

STATE OF KANSAS COUNTY OF RICE, ss.  
I, Noel J. Knight (employee of owner) or (OWNER OF OPERATION) of the above-described well, being first duly sworn on oath, says: That I have knowledge of the facts, statements, and matters herein contained and the log of the above-described well as filed and that the same are true and correct. So help me God.

(Signature) Noel Knight  
Chase, Kansas (Address)

SUBSCRIBED AND SWORN to before me this 23rd day of March, 1959

My commission expires 9-27-62 Thomas V. Duggs Notary Public.

PLUGGING  
FILE SEC 21 T 21 R 13W  
BOOK PAGE 14 LINE 2


COPY

W. P. FAULKNER  
Sipes "B" No. 1.

SEC. 21 T. 21 R. 13 W  
CEL NW SE

Total Depth. 3692'  
Comm. 3-10-43 Comp. 7-4-43  
Shot or Treated.  
Contractor.  
Issued. 9-4-43

County. Stafford

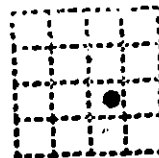

CASING:  
12 1/2" 256' Cem. cc  
5 1/2" 3681' Cem. 100 SX

Elevation.

Production. Phy. Pot. 417 B.

Figures Indicate Bottom of Formations.

surface gravel & sand	0-88
shale	195
sand white	235
sand hd	255
clay & shale	380
shale red	479
clay & shale	520
red bed	645
red bed & shells	735
shale & shells	1640
lime	2072
shale & lime	2112
lime	2306
shale	2350
lime & shale	2404
lime cherty	2418
lime	2430
shale & lime	2538
lime	2556
shale & lime	2611
lime	2677
lime & shale	2752
lime	2765
lime & shale	3005
lime	3209
lime & chert	3245
shale	3272
shale & lime shells	3330
lime	3419
lime & shale	3432
lime	3590
chert	3640
lime	3681
Arbuckle	3692
Total Depth.	

Tops:	
Lansing-K.C.	3354
Penna. Conglom.	3589
Viola	3610
Simpson	3634
Arbuckle	3681

RECEIVED  
STATE CORPORATION COMMISSION  
JAN 30 1959  
CONSERVATION DIVISION  
Wichita, Kansas

PLUGGING  
FILE SEC. 21 T. 21 R. 13 W  
BOOK PAGE 14 LINE 2