


Give All Information Completely
Make Required Affidavit
Mail or Deliver Report to:
Conservation Division
State Corporation Commission
212 No. Main St
Wichita, Kansas

WELL PLUGGING RECORD

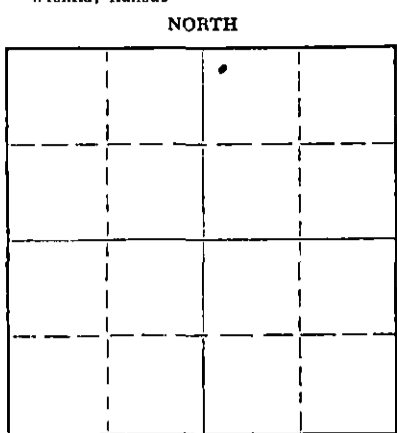

Stafford County. Sec. 21 Twp. 21S Rge. (E) 13(W)

Location as "NE/CNW/SW" or footage from lines NW NW NE
Lease Owner The Bovaird Supply Company
Lease Name Hoffman "A" Well No. 1
Office Address P.O. Box 2590, Tulsa, Oklahoma
Character of Well (completed as Oil, Gas or Dry Hole) oil
Date well completed _____ 19____
Application for plugging filed May 4 1967
Application for plugging approved _____ 19____
Plugging commenced May 9 1967
Plugging completed May 15 1967
Reason for abandonment of well or producing formation depleted

If a producing well is abandoned, date of last production _____ 19____
Was permission obtained from the Conservation Division or its agents before plugging was commenced? yes

Name of Conservation Agent who supervised plugging of this well Archie Elving
Producing formation _____ Depth to top _____ Bottom _____ Total Depth of Well 3672 Feet
Show depth and thickness of all water, oil and gas formations.

OIL, GAS OR WATER RECORDS

CASING RECORD

FORMATION	CONTENT	FROM	TO	SIZE	PUT IN	PULLED OUT
		0	317'	8 5/8"	317'	none
		0	3667'	5 1/2"	3667'	2803.60

Describe in detail the manner in which the well was plugged, indicating where the mud fluid was placed and the method or methods used in introducing it into the hole. If cement or other plugs were used, state the character of same and depth placed, from _____ feet to _____ feet for each plug set.

Pushed plug to 3650', set 10' rock bridge and dumped 5 sacks of cement at 3640'.

Pushed plug to 220', set 12' rock bridge and dumped 3 sacks of cement. Bailed hole down to 200' and dumped 25 sacks of cement. Filled hole with mud to 40', set 10' rock bridge and capped hole with 10 sacks of cement.

RECEIVED
STATE CORPORATION COMMISSION
MAY 10 1967
CONSERVATION DIVISION
WICHITA, KANSAS

(If additional description is necessary, use BACK of this sheet)
Name of Plugging Contractor Pipe Pullers, Inc.
Address Box 486, Ellinwood, Kansas

STATE OF Kansas, COUNTY OF Barton, ss.
Dean Wells (employee of owner) or (owner or operator) of the above-described well, being first duly sworn on oath, says: That I have knowledge of the facts, statements, and matters herein contained and the log of the above-described well as filed and that the same are true and correct. So help me God.

(Signature) Dean Wells
Ellinwood, Kansas (Address)

SUBSCRIBED AND SWORN TO before me this 17th day of May, 19 67

My commission expires July 7, 1968 J. J. Rader Notary Public.

15.185.10633.0000

WELL LOG BUREAU-- KANSAS GEOLOGICAL SOCIETY
508 E. Murdock, Wichita, Kansas

COPY

Company - PETROLEUM INC.
Farm - Hoffman

No. 1

SEC. 21 T. 21 R. 13W
- CW NE

Total Depth. 3676

Comm. 8-9-49

Camp. 8-22-49


County. Stafford

KANSAS

Shot or Treated.

Contractor. Jackson Drlg.

Issued. 10-29-49

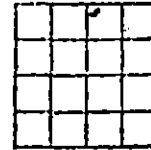

CASING:

8 5/8" 317 cem. w/250 sx.
5 1/2" 3637 cem. w/100 sx.

Elevation. _____

Production. Phys. 328

Figures Indicate Bottom of Formations.

sand & clay	85
shale & shells	335
shale & sand	420
red bed	740
anhyd.	765
shale	35
shale & shells	1545
shale	1620
lime & w/shale brks	1695
lime & shale	1825
lime	2105
lime & shale	2220
lime w/shale brks	2320
lime & shale	2845
shale	2880
lime w/shale brks	2945
lime	3185
shale & lime	3349
lime	3570
lime & shale	3593
lime & chert	3615
lime & shale	3665
Arbuckle	3676
Total Depth	

Tops:	
Anhyd.	740
Huebner	3201
Toronto	3220
B.O.	3236
Brown lime	3326
Lansing	3346
B. K. C.	3560
P. B. C.	3571
Viola	3584
Simpson	3626
Arbuckle	3665

* Measurements taken from top of derrick floor.

RECEIVED
CORPORATION COMMISSION
MAY 19 1967
CONSERVATION DIVISION
Wichita, Kansas