

AFFIDAVIT AND COMPLETION FORM

ACO-1

This form must be filed in triplicate with the Kansas Corporation Commission, 200 Colorado Derby Building, Wichita, Kansas 67202, within five days after the completion of the well, regardless of how the well was completed. Circle one: Oil gas, dry, SWD, OWWO, injection. Please type. Complete ALL sections. Applications must be filed for dual completion, commingling, salt water disposal and injection. Attach wireline logs (i.e. electrical log, sonic log, gamma ray neutron log, etc.) KCC#-(316) 263-3238.


OPERATOR ENERGY THREE, INC. API NO. 15 - 185 - 21,112.0000
 ADDRESS P. O. Box 1505 COUNTY STAFFORD
GREAT BEND, KANSAS 67530 FIELD W. C. TAYLOR NE
 **CONTACT PERSON R. D. STANDLEE LEASE MORRISON TRUST
 PHONE AC316-792-5968

PURCHASER Koch WELL NO. 2
 ADDRESS WICHITA, KANSAS WELL LOCATION NE SW NW
990 Ft. from WEST Line and
990 Ft. from SOUTH Line of
 the NW/4 SEC. 1 TWP. 21S RGE. 14W

DRILLING CONTRACTOR BIG THREE DRILLING, INC.
 ADDRESS P. O. Box 811
RUSSELL, KANSAS 67665

PLUGGING CONTRACTOR _____
 ADDRESS _____

TOTAL DEPTH 3619 PBTD _____
 SPUD DATE 10-20-81 DATE COMPLETED 10-31-81
 ELEV: GR1908DF KB 1913

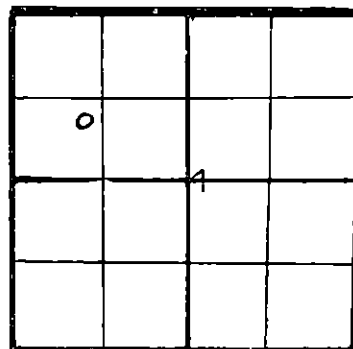

WELL PLAT
 (Quarter) or (Full) Section - Please indicate.

KCC
 KGS
 MISC.

DRILLED WITH (CABLE) (ROTARY) (AIR) TOOLS
 Report of all strings set - surface, intermediate, production, etc. (New) / (Used) casing.

Purpose of string	Size hole drilled	Size casing set (in O.D.)	Weight lbs/ft.	Setting depth	Type cement	Sacks	Type and percent additives
SURFACE	12 1/4	8 5/8	24 #	254	COMMON	225	3 % C.C. 2 % GEL. 1 1/4 # OF FLO-SEAL TO 1 SACK OF CEMENT.
PRODUCTION	7 7/8	4 1/2	9.5 #	3615	COMMON	175	10 % SALT 3/4 OF 1 % CFR2

LINER RECORD			PERFORATION RECORD		
Top, ft.	Bottom, ft.	Sacks cement	Shots per ft.	Size & type	Depth interval

TUBING RECORD		
Size	Setting depth	Pecker set at
2 7/8	3617	

ACID, FRACTURE, SHOT, CEMENT SQUEEZE RECORD	
Amount and kind of material used	Depth interval treated

TEST DATE:		PRODUCTION			
Date of first production	Producing method (flowing, pumping, gas lift, etc.)	A.P.I. Gravity			
10-31-81	PUMPING				
RATE OF PRODUCTION PER 24 HOURS	Oil	Gas	Water	Gas-oil ratio	
	80 bbls.		-0- bbls.		
Disposition of gas (vented, used on lease or sold)			Producing Interval		

** The person who can be reached by phone regarding any questions concerning this information.
 A witnessed initial test by the Commission is required if the well produces more than 25 BOPD or is located in a Basic Order Pool.

RECEIVED
 STATE CORPORATION COMMISSION
 NOV 20 1981
 11-23-1981
 CONSERVATION DIVISION
 Wichita, Kansas

Name of lowest fresh water producing stratum _____ Depth _____
 Estimated height of cement behind pipe CIRCULATED

WELL LOG

Show all important zones of porosity and contents thereof; cored intervals, and all drill-stem tests, including depth interval tested, cushion used, time tool open, flowing and shut-in pressures, and recoveries.

SHOW GEOLOGICAL MARKERS, LOGS RUN, OR OTHER DESCRIPTIVE INFORMATION.

FORMATION DESCRIPTION, CONTENTS, ETC.	TOP	BOTTOM	NAME	DEPTH
SAND	-0-	260		
SHALE	260	710		
SHALE & SAND	710	819		
ANHYDRITE	819	826		
SAND & SHALE	826	1720		
SHALE & LIME	1720	3275		
LIME	3275	3590		
LIME & SAND ARBUCKLE	3590	3619		
		T.D.		
			SAMPLE TOPS :	
			HEEBNER	3204
			BROWN LIME	3319
			LANS.-K.C.	3332
			ARBUCKLE	3612
			GREAT GUNS RAN OPEN HOLE LOG 10-26-81 FROM 3619 TO -0- AND A COMP. DENSITY LOG FROM 3619 TO 2900.	

USE ADDITIONAL SHEETS, IF NECESSARY, TO COMPLETE WELL RECORD.

A F F I D A V I T

STATE OF KANSAS, COUNTY OF BARTON SS,


R. D. STANDLEE OF LAWFUL AGE, BEING FIRST DULY SWORN UPON HIS OATH, DEPOSES AND SAYS:

THAT HE IS EXECUTIVE VICE-PRESIDENT FOR ENERGY THREE, INC. OPERATOR OF THE MORRISON TRUST LEASE, AND IS DULY AUTHORIZED TO MAKE THIS AFFIDAVIT FOR AND ON BEHALF OF SAID OPERATOR, THAT WELL NO. 2 ON SAID LEASE HAS BEEN COMPLETED AS OF THE 31st DAY OF OCTOBER 1981, AND THAT ALL INFORMATION ENTERED HEREIN WITH RESPECT TO SAID WELL IS TRUE AND CORRECT.

FURTHER AFFIANT SAITH NOT.

(S) *R. D. Standlee*

SUBSCRIBED AND SWORN TO BEFORE ME THIS 18th DAY OF NOVEMBER 1981

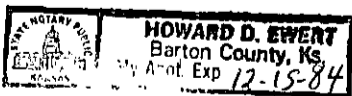

Howard D. Ewert
 NOTARY PUBLIC
 HOWARD D. EWERT

MY COMMISSION EXPIRES: DECEMBER 15, 1984