

This form shall be filed in duplicate with the Kansas Corporation Commission, 200 Colorado Derby Building, Wichita, Kansas 67202, within ten days after the completion of the well, regardless of how the well was completed.

Attach separate letter of request if the information is to be held confidential. If confidential, only file one copy. Information on side one will be of public record and side two will then be held confidential.

Circle one: Oil, Gas, Dry, SWD, OWWO, Injection. Type and complete ALL sections. Applications must be filed for dual completion, commingling, SWD and injection.

Attach wireline logs (i.e. electrical log, sonic log, gamma ray neutron log, etc.). KCC # (316) 263-3238. (Rules 82-2-105 & 82-2-125)

OPERATOR ENERGY THREE, INC.

API NO. 15-185-21,487.0000

ADDRESS P. O. Box 1505

COUNTY STAFFORD

GREAT BEND, KANSAS 67530

FIELD EXT/TAYLOR NE (LAN-ARB)

**CONTACT PERSON R. D. STANDLEE
PHONE AC 316-792-5968

PROD. FORMATION

PURCHASER

LEASE MORRISON TRUST

ADDRESS

WELL NO. 3

DRILLING BIG THREE DRILLING, INC.

WELL LOCATION 50' EAST OF CENT.

CONTRACTOR ADDRESS P. O. Box 52

S/2 NW NW

GORHAM, KANSAS 67640

710 Ft. from WEST Line and


990 Ft. from NORTH Line of

the NW/4 SEC. 1 TWP 21S RGE. 14W

PLUGGING SUN CEMENTING

WELL PLAT

CONTRACTOR ADDRESS GREAT BEND, KANSAS

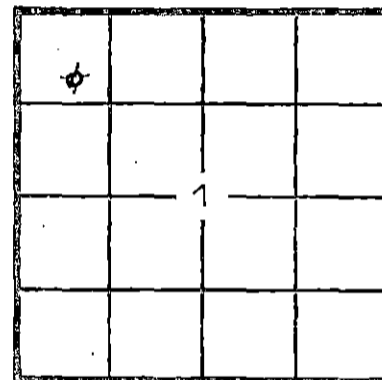

KCC
KGS
(Office Use)

TOTAL DEPTH 3740 PBTD

SPUD DATE 1-28-82 DATE COMPLETED 2-4-82

ELEV: GR 1910 DF KB 1915

DRILLED WITH (CABLE) (ROTARY) (AIR) TOOLS

Amount of surface pipe set and cemented 250

DV Tool Used? NO 2-24-1982

RECEIVED
STATE CORPORATION COMMISSION
FEB 24 1982
CONSERVATION DIVISION
Wichita, Kansas

AFFIDAVIT

STATE OF KANSAS, COUNTY OF BARTON SS, I,

R. D. STANDLEE OF LAWFUL AGE, BEING FIRST DULY SWORN UPON HIS OATH,

DEPOSES THAT HE IS EXECUTIVE VICE-PRES. (FOR) (OF) ENERGY THREE, INC.

OPERATOR OF THE MORRISON TRUST LEASE, AND IS DULY AUTHORIZED TO MAKE

THIS AFFIDAVIT FOR AND ON THE BEHALF OF SAID OPERATOR, THAT WELL NO. 3 ON

SAID LEASE HAS BEEN COMPLETED AS OF THE 4TH DAY OF FEBRUARY, 1982, AND THAT

ALL INFORMATION ENTERED HEREIN WITH RESPECT TO SAID WELL IS TRUE AND CORRECT.

FURTHER AFFIANT SAITH NOT.



(S) [Signature]

SUBSCRIBED AND SWORN BEFORE ME THIS 20TH DAY OF FEBRUARY, 1982

[Signature]

NOTARY PUBLIC HOWARD D. EWERT

MY COMMISSION EXPIRES: 12-15-84

**The person who can be reached by phone regarding any questions concerning this information. Within 45 days of completion, a witnessed initial test by the Commission is required if the well produces more than 25 BOPD or is located in a Basic Order Pool.

SIDE TWO

WELL LOG

Show all important zones of porosity and contents thereof; cored intervals, and all drill-stem tests, including depth interval tested, cushion used, time tool open, flowing and shut-in pressures, and recoveries.

SHOW GEOLOGICAL MARKERS, LOGS RUN, OR OTHER DESCRIPTIVE INFORMATION.

FORMATION DESCRIPTION, CONTENTS, ETC.	TOP	BOTTOM	NAME	DEPTH
TOP SOIL & SAND	-0-	256'	GREAT GUNS RAN OPEN HOLE LOG FROM TO -0- 2-4-82	3740
SHALE	256	818		
ANHYDRITE	818	825		
SAND & SHALE	825	1185		
SHALE & LIME	1185	3740		
		RTD		
			FORM. TOPS	ELEC. LOG)
			ANHYDRITE	818
			HEEBNER	3205
			BR. LIME	3323
			LANS.-K.C.	3334
			ARBUCKLE	3718

Report of all strings set— surface, intermediate, production, etc. **CASING RECORD** (New) or (Used)

Purpose of string	Size hole drilled	Size casing set (In O.D.)	Weight lbs/ft.	Setting depth	Type cement	Sacks	Type and percent additives
SURFACE	12 1/4	8 5/8	20 #	250	COMMON	225	3 % C.C. 2 % GEL

LINER RECORD

PERFORATION RECORD

Top, ft.	Bottom, ft.	Sacks cement	Shots per ft.	Size & type	Depth interval

TUBING RECORD		
Size	Setting depth	Packer set at

ACID, FRACTURE, SHOT, CEMENT SQUEEZE RECORD

Amount and kind of material used	Depth interval treated

Date of first production	Producing method (flowing, pumping, gas lift, etc.)	Gravity
DRY HOLE		

RATE OF PRODUCTION PER 24 HOURS	Oil bbls.	Gas bbls.	Water % MCF	Gas-oil ratio	CFPB
---------------------------------	-----------	-----------	-------------	---------------	------

Disposition of gas (vented, used on lease or sold)

Perforations