

SIDE ONE

Two (2) copies of this form shall be filed with the Kansas Corporation Commission, 200 Colorado Derby Building, Wichita, Kansas 67202, within thirty (30) days after the completion of a well, regardless of how the well was completed.

F Attach separate letter of request if the information is to be held confidential. If confidential, only file one copy. Information on Side One will be of public record and Side Two will then be held confidential.

Applications must be made on dual completion, commingling, salt water disposal, injection and temporarily abandoned wells.

C Attach one copy only wireline logs (i.e. electrical log, sonic log, gamma ray neutron log, etc.). (Rules 82-2-105 & 82-2-125) KCC# (316) 263-3238.

LICENSE # 5533 EXPIRATION DATE 6-30-83

OPERATOR Arrowhead Petroleum, Inc. API NO. 15 - 185 - 21,701.0000

ADDRESS P. O. Box 8287 - Munger Station COUNTY Stafford

Wichita, Kansas 67208 FIELD Mueller

** CONTACT PERSON Paul A. Seymour, III PROD. FORMATION
PHONE 681-3921

PURCHASER LEASE Schmalian

ADDRESS WELL NO. #1

DRILLING Big Springs Drilling, Inc. WELL LOCATION SE SE NE

CONTRACTOR P. O. Box 8287 - Munger Station 2310 Ft. from North Line and

ADDRESS Wichita, Kansas 67208 330 Ft. from East Line of (E)

the NE (Qtr.) SEC24 TWP21S RGE 13W(W).

PLUGGING Allied Cementing WELL PLAT (Office Use Only)

CONTRACTOR Russell, Kansas


TOTAL DEPTH 3615' PBTD

SPUD DATE 11-24-82 DATE COMPLETED 11-30-82

ELEV: GR 1858' DF KB 1863'

DRILLED WITH (CABLE) (ROTARY) (AIR) TOOLS.

DOCKET NO. OF DISPOSAL OR REPRESSURING WELL BEING USED TO DISPOSE OF WATER FROM THIS LEASE

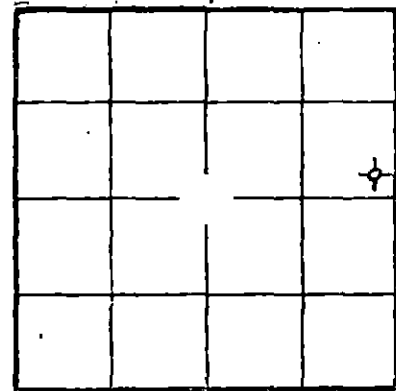

KCC
KGS
SWD/REP
PLG.

Amount of surface pipe set and cemented 250' DV Tool Used?

THIS AFFIDAVIT APPLIES TO: (Circle ONE) - Oil, Gas, Shut-in Gas, (Dry) Disposal, Injection, Temporarily Abandoned, OWWO. Other

ALL REQUIREMENTS OF THE STATUTES, RULES AND REGULATIONS PROMULGATED TO REGULATE THE OIL AND GAS INDUSTRY HAVE BEEN FULLY COMPLIED WITH.

A F F I D A V I T


Paul A. Seymour, III, being of lawful age, hereby certifies that:

I am the Affiant, and I am familiar with the contents of the foregoing Affidavit. The statements and allegations contained therein are true and correct.

Paul A. Seymour III
(Name)
Paul A. Seymour, III

SUBSCRIBED AND SWORN TO BEFORE ME this 3rd day of December

19 82.

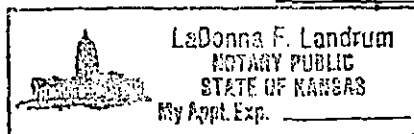

LaDonna F. Landrum
(NOTARY PUBLIC)
LaDonna F. Landrum

MY COMMISSION EXPIRES: August 18, 1984

RECEIVED
JUNSEPHAN DIVISION
Wichita, Kansas
DEC 15 1982

** The person who can be reached by phone regarding any questions concerning information.

12-15-1982