

STATE CORPORATION COMMISSION OF KANSAS
OIL & GAS CONSERVATION DIVISION

WELL COMPLETION OR RECOMPLETION FORM
ACO-1 WELL HISTORY

DESCRIPTION OF WELL AND LEASE

Operator: license # 5171
name TXO Production Corp.
address 155 N. Market
Suite 1000
City/State/Zip Wichita, Kansas 67202

Operator Contact Person Cory West
Phone (316) 269-7658

Contractor: license # 5107
name H-30 Drilling Co.

Wellsite Geologist Earl Moore
Phone (316) 775-6521

PURCHASER Panhandle Eastern

Designate Type of Completion
 New Well Re-Entry Workover

Oil SWD Temp Abd
 Gas Inj Delayed Comp.
 Dry Other (Core, Water Supply etc.)

If OWWO: old well info as follows:
Operator N/A
Well Name
Comp. Date Old Total Depth

WELL HISTORY

Drilling Method: Mud Rotary Air Rotary Cable
8-8-80 9-21-80 9-21-80
Spud Date Date Reached TD Completion Date

4820' 4710'
Total Depth PBTD

Amount of Surface Pipe Set and Cemented at 429' feet

Multiple Stage Cementing Collar Used? Yes No

If Yes, Show Depth Set feet

If alternate 2 completion, cement circulated
from feet depth to w/ SX cmt

API NO. 15 - 097-20,670 -0001

County Kiowa

SW/4 (location) Sec 11 Twp 28 Rge 16 East West

2310' Ft North from Southeast Corner of Section
4950' Ft West from Southeast Corner of Section
(Note: locate well in section plat below)


Lease Name Ross 'F' Well# 1

Field Name Wellsford

Producing Formation Bern Limestone

Elevation: Ground 2121' KB 2129'

Section Plat

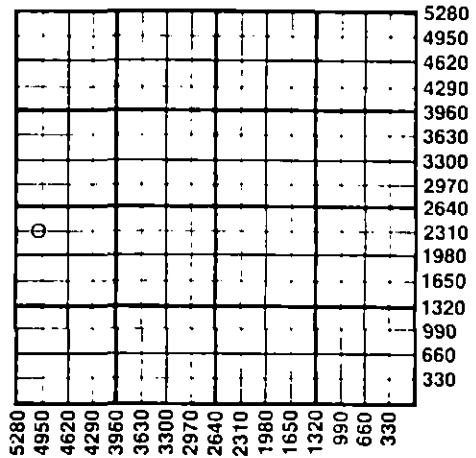

WATER SUPPLY INFORMATION

Source of Water:
Division of Water Resources Permit # N/A

Groundwater. Ft North From Southeast Corner and
(Well) Ft. West From Southeast Corner of
Sec Twp Rge East West

Surface Water. Ft North From Southeast Corner and
(Stream, Pond etc.) Ft West From Southeast Corner
Sec Twp Rge East West

Other (explain) (purchased from city, R.W.D.#)

Disposition of Produced Water: Disposal Repressuring

Docket #

INSTRUCTIONS: This form shall be completed in duplicate and filed with the Kansas Corporation Commission, 200 Colorado Derby Building, Wichita, Kansas 67202, within 90 days after completion or recompletion of any well. Rules 82-3-130 and 82-3-107 apply.

Information on side two of this form will be held confidential for a period of 12 months if requested in writing and submitted with the form. See rule 82-3-107 for confidentiality in excess of 12 months.

One copy of all wireline logs and drillers time log shall be attached with this form. Submit CP-4 form with all plugged wells. Submit CP-111 form with all temporarily abandoned wells.

All requirements of the statutes, rules, and regulations promulgated to regulate the oil and gas industry have been fully complied with and the statements herein are complete and correct to the best of my knowledge.

Signature Cory West
Title Area Production Engineer Date 11/25/85

Subscribed and sworn to before me this 25th day of November 19 85

Notary Public Connie F. Koehler
Date Commission Expires July 10, 1988

Connie F. Koehler
NOTARY PUBLIC
State of Kansas
MY AFPT. EXPIRES 7/10/88

K.C.C. OFFICE USE ONLY
F Letter of Confidentiality Attached
C Wireline Log Received
C Drillers Timelog Received
Distribution
 KCC SWD/Rep NGPA
 KGS Plug Other (Specify)

Form ACO-1 (7-84)

NOV 25 1985
11-26-85
CONSERVATION DIVISION

Sec. 11, Twp. 28, Rge. 16W

Operator Name TXO Production Corp. Lease Name Ross "F" Well# 1 SEC 11 TWP 28 RGE 16 East West

WELL LOG

INSTRUCTIONS: Show important tops and base of formations penetrated. Detail all cores. Report all drill stem tests giving interval tested, time tool open and closed, flowing and shut-in pressures, whether shut-in pressure reached static level, hydrostatic pressures, bottom hole temperature, fluid recovery, and flow rates if gas to surface during test. Attach extra sheet if more space is needed. Attach copy of log.

Drill Stem Tests Taken Yes No
 Samples Sent to Geological Survey Yes No
 Cores Taken Yes No

Formation Description
 Log Sample

Please refer to original ACO-1

Name Top Bottom
 Please refer to original ACO-1

CASING RECORD new used

Report all strings set - conductor, surface, intermediate, production, etc.

Purpose of string	size hole drilled	size casing set (in O.D.)	weight lbs/ft.	setting depth	type of cement	# sacks used	type and percent additives
Surface		8-5/8"		429'		375	
Production		4-1/2"	10.5#	4816'		150	

PERFORATION RECORD

Acid, Fracture, Shot, Cement Squeeze Record

shots per foot	specify footage of each interval perforated	(amount and kind of material used)	Depth
2 JSPF	4726-30'	Please refer to original ACO-1	
2 JSPF	4081-89'		
4 JSPF	3510-12'		250 gallons 15% HCl

TUBING RECORD

size 2-3/8" set at 3444' packer at

Liner Run Yes No

Date of First Production

9-21-80
8-16-85

Producing method

flowing pumping gas lift Other (explain)

Estimated Production Per 24 Hours

Oil	Gas	Water	Gas-Oil Ratio	Gravity
0.5 Bbls	1500 MCF	9.0 Bbls	CFPB	

Disposition of gas: vented sold used on lease

METHOD OF COMPLETION

open hole perforation other (specify)

PRODUCTION INTERVAL

Bern Limestone

Dually Completed. Commingled

3510-12'