

COPY

CONFIDENTIAL

SIDE ONE

STATE CORPORATION COMMISSION OF KANSAS
OIL & GAS CONSERVATION DIVISION
WELL COMPLETION FORM
ACO-1 WELL HISTORY
DESCRIPTION OF WELL AND LEASE

Operator: License # 5447Name: OXY USA Inc.Address P. O. Box 26100Oklahoma City, OK 73126-0100

City/State/Zip _____

Purchaser: CITGOOperator Contact Person: Raymond HuiPhone (405) 749-2471Contractor: Name: Allen Drilling Company

License: _____

Wellsite Geologist: Paul Ramondetta

Designate Type of Completion

☒ New Well ☐ Re-Entry ☐ Workover☒ Oil ☐ SWD ☐ Temp. Abd.☐ Gas ☐ Inj ☐ Delayed Comp.☐ Dry ☐ Other (Core, Water Supply, etc.)

If OWMG: old well info as follows:

Operator: _____

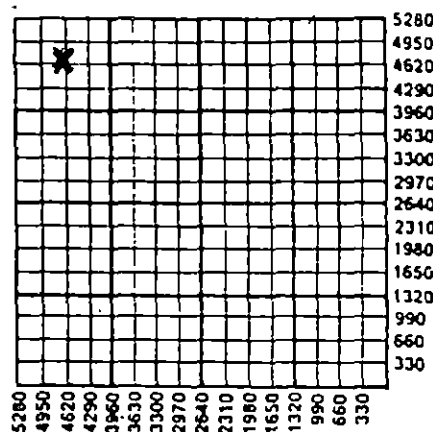
Well Name: _____

Comp. Date _____ Old Total Depth _____

Drilling Method:

☒ Mud Rotary ☐ Air Rotary ☐ Cable10-23-1989 10-28-1989 2-1-1990

Spud Date Date Reached TD Completion Date

API NO. 15-185-22621-0000County StaffordCNW NW Sec. 29 Twp. 21S Rge. 13 ☒ East ☐ West4620 Ft. North from Southeast Corner of Section4620 Ft. West from Southeast Corner of Section
(NOTE: Locate well in section plat below.)Lease Name Pundsack Unit Well # 412Field Name PundsackProducing Formation ArbuckleElevation: Ground 1907' KB 1912'Total Depth 3900' PBTD 3730'Amount of Surface Pipe Set and Cemented at 789 FeetMultiple Stage Cementing Collar Used? ☐ Yes ☒ No

If yes, show depth set _____ Feet

If Alternate II completion, cement circulated from _____

feet depth to _____ w/ _____ sx cmt.

INSTRUCTIONS: This form shall be completed in triplicate and filed with the Kansas Corporation Commission, 200 Colorado Derby Building, Wichita, Kansas 67202, within 120 days of the spud date of any well. Rule 82-3-130, 82-3-107 and 82-3-106 apply. Information on side two of this form will be held confidential for a period of 12 months if requested in writing and submitted with the form. See rule 82-3-107 for confidentiality in excess of 12 months. One copy of all wireline logs and drillers time log shall be attached with this form. ALL CEMENTING TICKETS MUST BE ATTACHED. Submit CP-4 form with all plugged wells. Submit CP-111 form with all temporarily abandoned wells. Any recompletion, workover or conversion of a well requires filing of ACO-2 within 120 days from commencement date of such work.

All requirements of the statutes, rules and regulations promulgated to regulate the oil and gas industry have been fully complied with and the statements herein are complete and correct to the best of my knowledge.

Signature Bryan HumphriesTitle Manager Engineering Date 2-21-1990Subscribed and sworn to before me this 21st day of February, 1990.Notary Public Deborah Kay MathisDate Commission Expires 3/24/90

K.C.C. OFFICE USE ONLY		
<input checked="" type="checkbox"/>	Letter of Confidentiality Attached	
<input type="checkbox"/>	Wireline Log Received	
<input type="checkbox"/>	Drillers Timelog Received	
Distribution		
<input checked="" type="checkbox"/>	KCC	<input type="checkbox"/> SWD/Rep
<input type="checkbox"/>	KGS	<input type="checkbox"/> Plug
		<input type="checkbox"/> NGPA
		<input type="checkbox"/> Other (Specify) <u>PI</u>