


WELL PLUGGING RECORD

Give All Information Completely
Make Required Affidavit
Mail or Deliver Report to:
Conservation Division
State Corporation Commission
211 No. Broadway
Wichita, Kansas

Stafford County, Sec. 30 Twp. 21S Rge. 12 (E) 13 (W)
Location as "NE/CNWxSWx" or footage from lines SE NW SE
Lease Owner Petroleum Operating Company
Lease Name Keenan Well No. 1
Office Address Box 7027 Tulsa, Oklahoma
Character of Well (completed as Oil, Gas or Dry Hole) Dry Hole
Date well completed 8-3 19 63
Application for plugging filed 8-3 19 63
Application for plugging approved 8-3 19 63
Plugging commenced 8-3 19 63
Plugging completed 8-3 19 63
Reason for abandonment of well or producing formation Dry Hole

NORTH

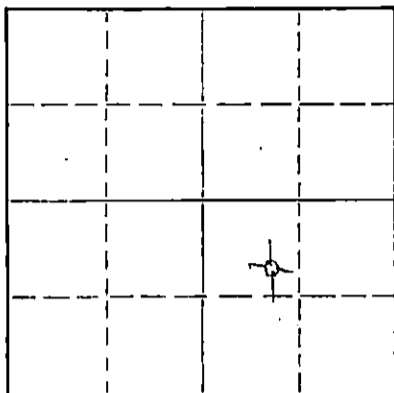

Locate well correctly on above
Section Plat

If a producing well is abandoned, date of last production 19
Was permission obtained from the Conservation Division or its agents before plugging was commenced? Yes

Name of Conservation Agent who supervised plugging of this well Gilbert Thomas
Producing formation Dry Hole Depth to top Bottom Total Depth of Well 3744 Feet
Show depth and thickness of all water, oil and gas formations.

OIL, GAS OR WATER RECORDS

CASING RECORD

FORMATION	CONTENT	FROM	TO	SIZE	PUT IN	PULLED OUT
Lansing	water	3378	3592	8-5/8	211	none
Arbuckle	water	3734	3744			

Describe in detail the manner in which the well was plugged, indicating where the mud fluid was placed and the method or methods used in introducing it into the hole. If cement or other plugs were used, state the character of same and depth placed, from feet to feet for each plug set.

Set plug at 240' w/1/4 sx hulls and 25 sx cement through drill pipe
Set plug @ 45' w/1/4 sx hulls and 10 sx cement
2 sx in rat hole

RECEIVED
STATE CORPORATION COMMISSION

AUG 16 1963

CONSERVATION DIVISION
Wichita, Kansas

Name of Plugging Contractor Rotary well -- no pipe set
Address

STATE OF OKLAHOMA, COUNTY OF TULSA, ss.
Joseph Teichman (employee of owner) or (owner or operator) of the above-described well, being first duly sworn on oath, says: That I have knowledge of the facts, statements, and matters herein contained and the log of the above-described well as filed and that the same are true and correct. So help me God.

(Signature) Joseph Teichman
P.O. Box 7027 Tulsa, Oklahoma
(Address)

SUBSCRIBED AND SWORN to before me this 15th day of August, 19 63

My commission expires 3-17-64

Notary Public.

