


WELL PLUGGING RECORD

Give All Information Completely
Make Required Affidavit
Mail or Deliver Report to:
Conservation Division
State Corporation Commission
800 Biting Building
Wichita, Kans.

Barton County. Sec. 30 Twp. 21 Rge. (E) 13 (W)
Location as "NE/CNW/SW" or footage from lines C S/2 NE SE

Lease Owner Thunderbird Drilling, Inc.
Lease Name Keenan Well No. 1
Office Address 1311 Union National Bank Bldg., Wichita, Kans.
Character of Well (completed as Oil, Gas or Dry Hole) Oil
Date well completed May 22 19 54
Application for plugging filed March 13 19 56
Application for plugging approved March 13 19 56
Plugging commenced March 8 19 56
Plugging completed March 13 19 56
Reason for abandonment of well or producing formation Turned to water

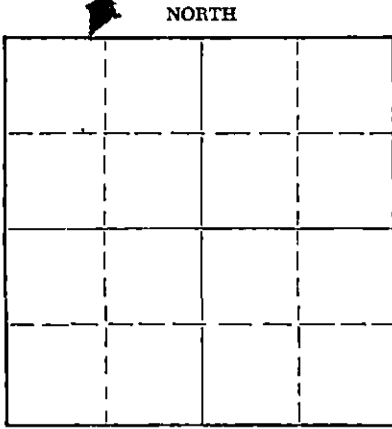

Locate well correctly on above Section Plat

If a producing well is abandoned, date of last production Feb. 29 19 56
Was permission obtained from the Conservation Division or its agents before plugging was commenced? Yes

Name of Conservation Agent who supervised plugging of this well R. M. Brundage
Producing formation Kansas City Depth to top 3539' Bottom 3545' Total Depth of Well 3780 Feet
Show depth and thickness of all water, oil and gas formations.

OIL, GAS OR WATER RECORDS

CASING RECORD

FORMATION	CONTENT	FROM	TO	SIZE	PUT IN	PULLED OUT
				8 5/8"	355'	None
				5 1/2"	3776'	2111'

Describe in detail the manner in which the well was plugged, indicating where the mud fluid was placed and the method or methods used in introducing it into the hole. If cement or other plugs were used, state the character of same and depth placed, from _____ feet to _____ feet for each plug set.

Cast Iron plug set from 3559 to 3557, Crushed rock from 3557 to 3530, Cement plug from 3530 to 2495, Mud from 2495 to 225, Crushed rock from 225 to 215, Cement plug from 215 to 165, Mud from 165 to 35, Crushed rock from 35 to 25, Cement plug from 25 to surface.

(If additional description is necessary, use BACK of this sheet)

Name of Plugging Contractor Miller Casing Pulling Company
Address P. O. Box 711, Great Bend, Kansas License No. 12

STATE OF KANSAS, COUNTY OF SEDGWICK, ss.
Charles W. Aikins, Jr. (employee of owner) or (owner or operator) of the above-described well, being first duly sworn on oath, says: That I have knowledge of the facts, statements, and matters herein contained and the log of the above-described well as filed and that the same are true and correct. So help me God.

(Signature) Charles W. Aikins, Jr.
1311 Union National Bank Bldg. (Address)

SUBSCRIBED AND SWORN to before me this 16th day of May, 19 56

Leta Helm
Leta Helm Notary Public.

My commission expires August 25, 1956

PLUGGING
FILE SEC 30 T. 21 R. 13W
BOOK PAGE 45 LI. E. 28

RECEIVED
STATE CORPORATION COMMISSION
MAY 17 1956 5-17-1956
CONSERVATION DIVISION
Wichita, Kansas


WELL LOG BUREAU—KANSAS GEOLOGICAL SOCIETY
508 East Murdock, Wichita, Kansas

Company: THUNDERBIRD DRILG., INC.
Farm: Keenan No. 1

SEC. 30 T. 21 R. 13W
C S $\frac{1}{2}$ NE SE

Total Depth. 3870'
Comm. 5-1-54 Comp. 5-22-54
Shot or Treated.
Contractor. Thunderbird Drilg. Inc.
Issued. 8-14-54

County Stafford
KANSAS

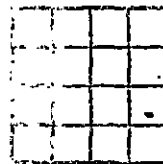

Elevation. 1911'

Production. 31 BO/85% wtr.

Figures Indicate Bottom of Formations.

sand-shale	355
s hale-red ved-	795
anhydrite	820
shale-shells	1250
salt	1350
shale-lime	2400
shale-shells	2570
shale-lime	3030
lime	3220
l ime-shale	3360
lime	3610
lime-shert	3678
shale	3730
shale-limo	3737
lime	3765
lime	3780 RTD
Total Depth	

TOPS: Scout
Lansing 3374

RECEIVED
STATE CORPORATION COMMISSION
MAY 10 1956
CONSERVATION DIVISION
Wichita, Kansas

PLUGGING
FILE SEC. 30 T. 21 R. 13W
BOOK PAGE 45 LINE 28