


STATE OF KANSAS  
STATE CORPORATION COMMISSION

WELL PLUGGING RECORD

Give All Information Completely  
Make Required Affidavit  
Mail or Deliver Report to:  
Conservation Division  
State Corporation Commission  
800 Biting Building  
Wichita, Kansas

Stafford County. Sec. 30 Twp. 21 Rge. 13 ~~W~~ (W)  
Location as "NE/CNW%SW%" or footage from lines NE/4 NE/4 SE/4  
Lease Owner Pan American Petroleum Corporation  
Lease Name J. Keenan Well No. 2  
Office Address P.O. Box 7, Ellinwood, Kansas  
Character of Well (completed as Oil, Gas or Dry Hole) Oil  
Date well completed 6-11- 19 51  
Application for plugging filed 12-9- 19 58  
Application for plugging approved 12-10- 19 58  
Plugging commenced 1-16- 19 59  
Plugging completed 1-22- 19 59  
Reason for abandonment of well or producing formation Depleted

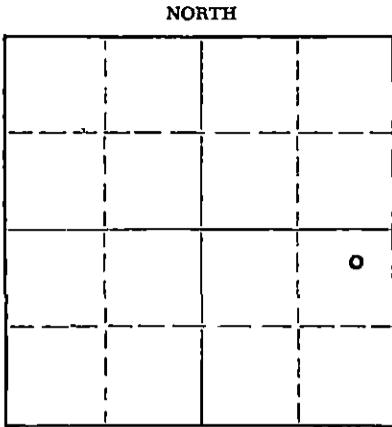

Locate well correctly on above Section Plat

If a producing well is abandoned, date of last production 12-24- 19 58  
Was permission obtained from the Conservation Division or its agents before plugging was commenced? Yes

Name of Conservation Agent who supervised plugging of this well Frank Broadfoot  
Producing formation Lansing Depth to top 3550 Bottom 3556 Total Depth of Well PB 3600 Feet  
Show depth and thickness of all water, oil and gas formations.

OIL, GAS OR WATER RECORDS

CASING RECORD

FORMATION	CONTENT	FROM	TO	SIZE	PUT IN	PULLED OUT
Arbuckle	Oil-Depleted	3722	3727	5-1/2"	3745	2792
Lansing	Oil-Depleted	3550	3556			
				8-5/8"	809	0

Describe in detail the manner in which the well was plugged, indicating where the mud fluid was placed and the method or methods used in introducing it into the hole. If cement or other plugs were used, state the character of same and depth placed, from \_\_\_\_\_ feet to \_\_\_\_\_ feet for each plug set.

- 3600-3431 150 Gal. Sand & 5 Sx Cement
- 3431- 300 Heavy Mud
- 300- 290 Rock
- 290- 200 25 Sx Cement
- 200- 35 Heavy Mud
- 35- 30 Rock
- 30- Bottom of Cellar 10 Sx Cement

RECEIVED  
STATE CORPORATION COMMISSION  
JAN 29 1959  
CONSERVATION DIVISION  
Wichita, Kansas

(If additional description is necessary, use BACK of this sheet)

Name of Plugging Contractor West Supply Company, Inc.  
Address Chase, Kansas

STATE OF Kansas, COUNTY OF Barton, ss.  
G. A. Reynolds (employee of owner) or (owner) of the above-described well, being first duly sworn on oath, says: That I have knowledge of the facts, statements, and matters herein contained and the log of the above-described well as filed and that the same are true and correct. So help me God.

(Signature) [Signature]  
P.O. Box 7, Ellinwood, Kansas  
(Address)

SUBSCRIBED AND SWORN TO before me this 28th day of January, 19 59

My commission expires May 3, 1961

[Signature]  
Notary Public.

PLUGGING  
FILE SEC 20 T. 21 R. 13W  
BOOK PAGE 3 LINE 1