

WELL PLUGGING RECORD

STATE OF KANSAS STATE CORPORATION COMMISSION


FORMATION PLUGGING RECORD

Give All Information Completely Make Required Affidavit Mail or Deliver Report to: Conservation Division State Corporation Commission 800 Blitting Building Wichita, Kansas

Strike out upper line when reporting plugging of formations.

Stafford County, Sec 30 Twp 21 Rge 13 #11 (W)

Location as "NE1/4NW1/4SW1/4" or footage from lines NE1/4, NE1/4, NE1/4 Lease Owner Harbar Drlg. Co., Etal Lease Name Brown Estate Well No. 1 Office Address 8019 Central Bldg., Wichita, Kans. Character of Well (completed as Oil, Gas or Dry Hole) Rotary, Dry Hole Date well completed November 19 1948 Application for plugging filed November 18 1948 Application for plugging approved November 18 1948 Plugging commenced November 19 1948 Plugging completed November 19 1948 Reason for abandonment of well or producing formation No production If a producing well is abandoned, date of last production XXXXXXXXXXXX 19. Was permission obtained from the Conservation Division or its agents before plugging was commenced? Yes

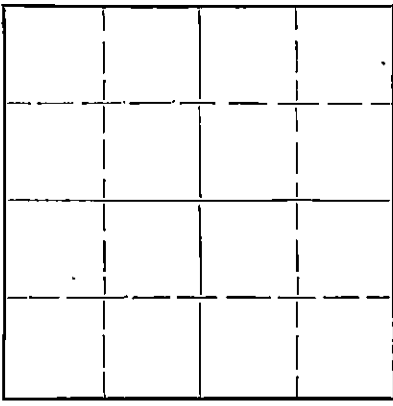

Locate well correctly on above Section Plat

Name of Conservation Agent who supervised plugging of this well C. D. Stough Producing formation None Depth to top Bottom Total Depth of Well 3,800 Feet Show depth and thickness of all water, oil and gas formations.

OIL, GAS OR WATER RECORDS

CASING RECORD

Table with 7 columns: Formation, Content, From, To, Size, Put In, Pulled Out. Row 1: Surface sand & gravel, Fresh water, 0, 180, 85/8, 363, None.

Describe in detail the manner in which the well was plugged, indicating where the mud fluid was placed and the method or methods used in introducing it into the hole. If cement or other plugs were used, state the character of same and depth placed, from feet to feet for each plug set.

Filled hole with heavy rotary mud from 3800 back to 200 feet. Set Halliburton plug at 200 feet and dumped 15 sacks of cement on top of plug. Filled hole with heavy mud from top of cement to 30 feet of top of hole where another Halliburton plug was set and dumped 10 sacks of cement on top of plug filling top of the surface casing to top and in bottom of the cellar.

NOV 26 11-26-1948

Correspondence regarding this well should be addressed to Harbar Drlg. Col, 1019 Central Bldg., Wichita, Mans. Address


STATE OF Kansas COUNTY OF Barton I, Roy Cook (employee of owner) or of the above-described well, being first duly sworn on oath, says: That I have knowledge of the facts, statements, and matters herein contained and the log of the above-described well as filed and that the same are true and correct. So help me God.

(Signature) Roy Cook

SUBSCRIBED AND SWORN to before me this 23rd day of November, 1948

(Address) Roy Gillig Notary Public.

My commission expires 9-4-50

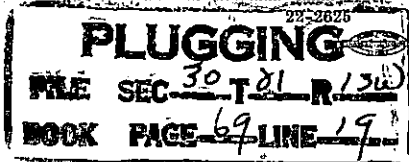

BROWN ESTATE #1

Center NE $\frac{1}{4}$  NE $\frac{1}{4}$  NW $\frac{1}{4}$  of Sec. 30-21S-13W, Stafford County, Kansas

Rigging up Rotary Tools 10-30-48 Run 18 Jts 8 5/8" surface pipe. Set @  
 Tearing down Rotary Tools 11-20-48 363' and cemented with 200 sx cement

<u>FORMATION</u>	<u>FROM</u>	<u>TO</u>
Surface clay	0	145
Sand and shale	145	363
Red bed and shells	363	545
Shale and shells	545	1375
Salt and shells	1375	1460
Shale and shells	1460	1695
Lime	1695	1810
Lime and shale	1810	1970
Broken Lime	1970	2040
Hard lime	2040	2084
Lime	2084	2355
Shale shells	2355	2475
Shale and lime	2475	2634
Shale and broken lime	2634	2786
Shale shells	2786	2883
Shale	2883	3023
Shale and lime	3023	3105
Shale and lime shells	3105	3200
Shale and lime	3200	3400
Lime	3400	3461
Lime, broken sand	3461	3500
Kansas City Lime	3500	3535
Lime	3535	3632
Broken Lime	3632	3702
Shale	3702	3740
Simpson Shale	3740	3755
Shale	3755	3800 Total Depth

I, Don S. Packer, hereby certify that the above Log is true and correct, to the best of my knowledge and belief.

Subscribed and sworn to before me this 23rd day of November, 1948.

RECEIVED  
 NOV 26 1948  
 STAFFORD COUNTY  
 COMMISSIONER

*[Signature]*  
 Notary Public

My commission expires: March 22, 1952

PLUGGING  
 FILE SEC 30 T. 21. R. 13W  
 ROCK PAGE 69 LINE 19