


WELL PLUGGING RECORD

Give All Information Completely
Make Required Affidavit
Mail or Deliver Report to:
Conservation Division
State Corporation Commission
800 Bitting Building
Wichita, Kansas

NORTH

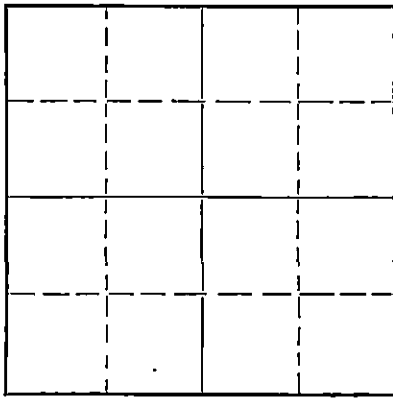

Locate well correctly on above
Section Plot

Stafford County. Sec. 30 Twp. 21 Rge. 13 (B) (W)
Location as "NE/CNW $\frac{1}{4}$ SW $\frac{1}{4}$ " or footage from lines NW NW NW
Lease Owner Petroleum, Inc.
Lease Name Brown 'C' Well No. 3
Office Address 100 Derby Building, Wichita, Kansas
Character of Well (completed as Oil, Gas or Dry Hole) Dry Hole
Date well completed January 28, 1951 19 51
Application for plugging filed January 28, 19 51
Application for plugging approved January 28, 19 51
Plugging commenced January 28, 19 51
Plugging completed January 28, 19 51
Reason for abandonment of well or producing formation Dry Hole

If a producing well is abandoned, date of last production 19
Was permission obtained from the Conservation Division or its agents before plugging was commenced? Yes

Name of Conservation Agent who supervised plugging of this well Mr. C. D. Stough
Producing formation Depth to top Bottom Total Depth of Well 3758 Feet
Show depth and thickness of all water, oil and gas formations.

OIL, GAS OR WATER RECORDS

CASING RECORD

Formation	Content	From	To	Size	Put In	Pulled Out
				8 5/8"	205'	None

Describe in detail the manner in which the well was plugged, indicating where the mud fluid was placed and the method or methods used in introducing it into the hole. If cement or other plugs were used, state the character of same and depth placed, from feet to feet for each plug set.

Wooden plug set at 200'. Cemented and displaced through drill pipe 15 sax. Filled hole with heavy mud to 30'. Placed wooden plug at 30'. Filled hole to surface with cement.

RECEIVED
STATE CORPORATION COMMISSION
JAN 31 1951
CONSERVATION DIVISION
Wichita, Kansas

(If additional description is necessary, use BACK of this sheet)

Correspondence regarding this well should be addressed to Petroleum, Inc.
Address 100 Derby Building, Wichita 2, Kansas

STATE OF KANSAS, COUNTY OF SEDGWICK, ss.
Eric H. Jager (employee of owner) of (owner or operator) of the above-described well, being first duly sworn on oath, says: That I have knowledge of the facts, statements, and matters herein contained and the log of the above-described well as filed and that the same are true and correct. So help me God.

(Signature) Eric H. Jager
100 Derby Bldg., Wichita 2, Kansas
(Address)

SUBSCRIBED AND SWORN to before me this 30th day of January, 19 51

Charlotte Heidman
Notary Public.

My commission expires October 13, 1954

PLUGGING
FILE SEC 30 T 21 R 13w
BOOK PAGE 58 LINE 45

WELL LOG BROWN 'C' #3

Petroleum, Inc., Lease Owner

Section 30, Twp. 21S, Rge. 13W

Garvey Oil, Contractor

Location: NW NW NW

Rotary Total Depth: 3758'

County: Stafford, Kansas

Commenced: January 15, 1951

Production: D & A

Completed: January 28, 1951

Elevation: 1921 D.F.

Casing: 205' of 8 5/8"

Figures below indicate bottom of formation:

100 Sand
 115 Hard Sand
 130 Shale
 205 Shale & Shells
 224 Blue Shale
 248 Sandy Shale
 330 Soft Sand
 357 Grey shale & Shells
 813 Red Bed
 835 Anhydrite
 1325 Shale & Shells
 1425 Salt & Shale
 1665 Shale & Shells
 1790 Lime & Shale
 1950 Br. Lime
 2120 Lime & Shale
 2455 Shale & Shells
 2775 Shale & Lime
 3140 Lime
 3300 Lime & Shale
 3350 Shale
 3420 Lime
 3640 Lime & Shale
 3689 Lime
 3701 Shale
 3753 Arb. Lime

3260
 3279
 3296
 3383
 3393
 3611
 3647
 3699
 3749

Tops:
 Heebner
 Toronto
 Base Oread
 Brown Lime
 Lansing
 B.K.C.
 Conglomerate
 Simpson
 Arbuckle

DST 3750-53, open 1/2 hour, rec. 6' drilling mud.

DST 3750-58, open 2 hours, rec. 60' of slightly oil cut mud.


3758 R.T.D.

RECEIVED
 STATE CORPORATION COMMISSION
 JAN 31 1951
 CONSERVATION DIVISION
 Wichita, Kansas

I hereby certify that this is a true and correct log of the above mentioned well.

PETROLEUM, INC.

STATE OF KANSAS:
 SEDGWICK COUNTY:

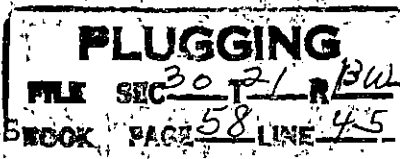

Eric R. Jago

Subscribed to and sworn to before me, a Notary Public in said County and State this 30th day of January, 1951.

My commission expires: 10-13-54

Charlotte Heidman
 Notary Public