


WELL PLUGGING RECORD

Give All Information Completely  
Make Required Affidavit  
Mail or Deliver Report to:  
Conservation Division  
State Corporation Commission  
800 Bittling Building  
Wichita, Kansas

NORTH

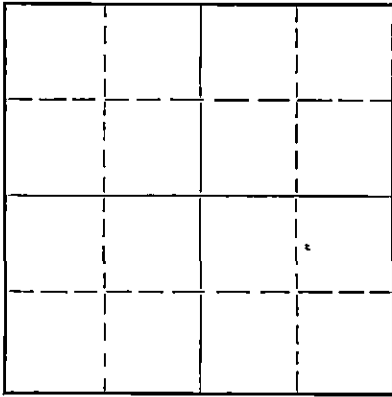

Locate well correctly on above  
Section Plat

Stafford County, Sec. 30 Twp. 21 Rge. 13 (E) (W)  
Location as "NE/CNW $\frac{1}{4}$ SW $\frac{1}{4}$ " or footage from lines NE SW NW  
Lease Owner Petroleum, Inc.  
Lease Name Brown 'C' Well No. 5  
Office Address 100 Derby Bldg., Wichita, Kansas  
Character of Well (completed as Oil, Gas or Dry Hole) Dry Hole  
Date well completed December 15, 1952  
Application for plugging filed December 15, 1952  
Application for plugging approved December 15, 1952  
Plugging commenced December 15, 1952  
Plugging completed December 15, 1952  
Reason for abandonment of well or producing formation Dry Hole

If a producing well is abandoned, date of last production 19...  
Was permission obtained from the Conservation Division or its agents before plugging was commenced? Yes

Name of Conservation Agent who supervised plugging of this well Mr. C. D. Stough  
Producing formation Depth to top Bottom Total Depth of Well 3764 Feet  
Show depth and thickness of all water, oil and gas formations.

OIL, GAS OR WATER RECORDS

CASING RECORD

Formation	Content	From	To	Size	Put In	Pulled Out
				8 5/8"	206'	None

Describe in detail the manner in which the well was plugged, indicating where the mud fluid was placed and the method or methods used in introducing it into the hole. If cement or other plugs were used, state the character of same and depth placed, from...feet to...feet for each plug set.

Set wooden plug at 200'. Cemented and displaced through drill pipe 15 sax cement from 200' to 160'. Mudded up from 160' to 35'. Placed wooden plug at 35'. Dumped 10 sax cement from 35' to bottom of cellar.

JAN 22 1952 1-22-1952

(If additional description is necessary, use BACK of this sheet)

Correspondence regarding this well should be addressed to Petroleum, Inc.  
Address 100 Derby Bldg., Wichita, Kansas

STATE OF KANSAS, COUNTY OF SEDGWICK, ss.  
Eric H. Jager (employee of owner) or (owner or operator) of the above-described well, being first duly sworn on oath, says: That I have knowledge of the facts, statements, and matters herein contained and the log of the above-described well as filed and that the same are true and correct. So help me God.

(Signature) Eric H. Jager  
100 Derby Bldg., Wichita, Kansas (Address)

SUBSCRIBED AND SWORN TO before me this 21st day of January, 1952

Charlotte Heidman  
Notary Public.

My commission expires October 13, 1954

PLUGGED  
FILE SEC 307 21/218  
BOOK PAGE 131 LINE 4

DRILLER'S LOG BROWN 'C' #5

Petroleum, Inc. Lease Owner

Section 30, Twp. 21S, Rge. 13W

Garvey Drilling Co., Contractor

Location: NE SW NW

Drilling Commenced: December 3, 1951

County: Stafford

Drilling Completed: December 15, 1951

R.T.D.: 3764'

Casing: 8 5/8"  $\odot$  207' w/175 sax

Productions: D & A

All figures indicate bottom of formation:

130 Sand  
 206 Shale & Shells  
 240 Shale  
 300 Sand  
 813 Red Bed  
 835 Anhydrite  
 1700 Shale & Shells  
 2140 Lime  
 2500 Lime & Shale  
 2595 Shale & Shells  
 2975 Lime & Shale  
 3075 Lime  
 3170 Lime & Shale  
 3616 Lime  
 3640 Lime & Shale  
 3685 Chert  
 3725 Lime  
 3743 Shale & Lime  
 3764 Lime

3764' R.T.D.

Tops:

Heebner: 3254 (-1330)  
 Brown Lime: 3376 (-1452)  
 Lansing: 3386 (-1462)  
 Arbuckle: 3739 (-1815)

I hereby certify that this is a true and correct log of the above mentioned well.

PETROLEUM, INC.

TESTED AND APPROVED BY

*Eric H. Jager*

Eric H. Jager

JAN 22 1952

STATE OF KANSAS )  
 )  
 COUNTY OF SEDGWICK )

SS:

Subscribed to and sworn to before me, a Notary Public, in said County and State, this 31st, day of December, 1951.

PLUGGING  
 FILE NO. 30121-130  
 131  
 MY COMMISSION EXPIRES: OCTOBER 13, 1954

*Charlotte Heiman*  
 Notary Public

My commission expires: October 13, 1954