


WELL PLUGGING RECORD

Give All Information Completely
Make Required Affidavit
Mail or Deliver Report to:
Conservation Division
State Corporation Commission
800 Bitting Building
Wichita, Kansas

NORTH

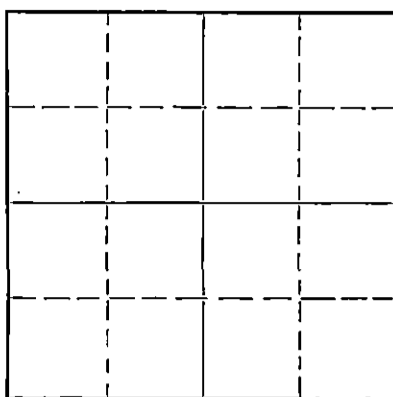

Locate well correctly on above
Section Flat

Stafford County. Sec. 30 Twp. 21 Rge. (E) 13 (W)
Location as "NE/CNW $\frac{1}{4}$ SW $\frac{1}{4}$ " or footage from lines SE SE NE $\frac{1}{4}$
Lease Owner M. B. Armer
Lease Name Brown Well No. _____
Office Address 710 Petroleum Building, Wichita, Kansas
Character of Well (completed as Oil, Gas or Dry Hole) Dry
Date well completed August 20 1951
Application for plugging filed August 20 1951
Application for plugging approved August 20 1951
Plugging commenced August 20 1951
Plugging completed August 20 1951
Reason for abandonment of well or producing formation Dry

If a producing well is abandoned, date of last production _____ 19____
Was permission obtained from the Conservation Division or its agents before plugging was commenced? Yes

Name of Conservation Agent who supervised plugging of this well C. D. Stough
Producing formation _____ Depth to top 3,743 Bottom 3,765 Total Depth of Well 3,765 Feet
Show depth and thickness of all water, oil and gas formations.

OIL, GAS OR WATER RECORDS

CASING RECORD

Formation	Content	From	To	Size	Put In	Pulled Out
				8 5/8	303'	None

Describe in detail the manner in which the well was plugged, indicating where the mud fluid was placed and the method or methods used in introducing it into the hole. If cement or other plugs were used, state the character of same and depth placed, from _____ feet to _____ feet for each plug set.

Filled hole full of heavy mud, set plug and 15 sacks cement at 300 ft.
Mud to 35 ft., set plug and 10 sacks cement at the surface.

RECEIVED
STATE CORPORATION COMMISSION
AUG 20 1951
CONSERVATION DIVISION
WICHITA, KANSAS

(If additional description is necessary, use BACK of this sheet)

Correspondence regarding this well should be addressed to M. B. Armer
Address _____

STATE OF Kansas, COUNTY OF Sedgwick, ss.
L. C. Sponenberg (employee of owner) or (~~owner or operator~~) of the above-described well,
being first duly sworn on oath, says: That I have knowledge of the facts, statements, and matters herein contained and the log of the above-described well as filed and that the same are true and correct. So help me God.

(Signature) L. C. Sponenberg
(Address) _____

SUBSCRIBED AND SWORN to before me this 28th day of August, 1951.

My commission expires Sept. 17, 1951

Hazel Carter
Notary Public.

PLUGGING
FILE SEC 30 21 R3w
BOOK PAGE 105 LINE 7

LOG

Company: M. B. Armer
Contractor: M. B. Armer
Drilling commenced: 8/9/51
Drilling completed: 8/21/51
Elevation: 1910 Gr.
1912 D.F.
1915 R.B.

Farm: Brown #1
Location: SE SE NE¹/₄ Sed. 30-21S.-13W
Stafford County, Kansas
Casing Record 8-5/8" set @ 303 ft.
cemented w/250 sacks

(figures below indicate bottom)

Cellar	8	
Sand & shale	200	
Sand & gravel	290	
Shale	303	
Red Bed & sand	375	
Red Bed, Sand, Shale & Shells	785	
Anhydrite	820	
Shale & shells	1575	
Shale & lime	2515	
Shale, lime & shells	2665	
Shale & lime	3380	
Lime	3690	
Shale	3743	
Dolomite	3765	
Rotary Total Depth	3765	<u>D & A</u>

FORMATION TOPS: (R. B. meas.)

Heebner	3235
Brown Lime	3360
Lans. -Kansas City	3369
Conglomerate	3625
Viola	3643
Simpson	3685
Arbuckle	3743

I hereby certify that this is a true and correct log of the above described well as shown by the drilling reports.

M. B. Armer

By *J. W. Speer*

STATE OF KANSAS)
) SS.
COUNTY OF SEDGWICK)

Subscribed and sworn to before me, a notary public, in and for said County and State this 22nd. day of August, 1951.

Harold Walter
Notary Public.

My commission expires Sept. 17, 1951

STATE OF KANSAS
AUG 29 1951

PLUGGING
WELL SEC 30 21 R (34)
DROK PAC 105 LINS 17