


Give All Information Completely
Make Required Affidavit
Mail or Deliver Report to:
Conservation Division
State Corporation Commission
211 No. Broadway
Wichita, Kansas

WELL PLUGGING RECORD

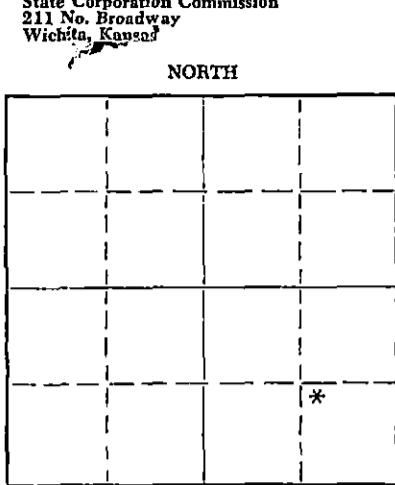

Locate well correctly on above Section Plat

Stafford County, Sec. 29 Twp. 21S Rge. 13 (E) W (W)
Location as "NE/CNW/SW" or footage from lines 300' west of NW SE SE
Lease Owner Altman-Sylvan Oil Company
Lease Name Keller Well No. 1
Office Address 810 Midstates Building Tulsa, Oklahoma
Character of Well (completed as Oil, Gas or Dry Hole) dry hole
Date well completed April 16 1957
Application for plugging filed April 16 1957
Application for plugging approved April 16 1957
Plugging commenced 10:00 a.m. April 16 1957
Plugging completed 12:00 noon April 16 1957
Reason for abandonment of well or producing formation dry hole

If a producing well is abandoned, date of last production 19
Was permission obtained from the Conservation Division or its agents before plugging was commenced? Yes

Name of Conservation Agent who supervised plugging of this well R. M. Brundege
Producing formation _____ Depth to top _____ Bottom _____ Total Depth of Well 3833 Feet
Show depth and thickness of all water, oil and gas formations.

OIL, GAS OR WATER RECORDS

CASING RECORD

FORMATION	CONTENT	FROM	TO	SIZE	PUT IN	PULLED OUT
Surface pipe		-0-	308'	8 5/8"	308'	-0-

Describe in detail the manner in which the well was plugged, indicating where the mud fluid was placed and the method or methods used in introducing it into the hole. If cement or other plugs were used, state the character of same and depth placed, from _____ feet to _____ feet for each plug set.

Filled hole with heavy mud.
Pushed 1/3 sack hulls and plug on top to 210'.
Cemented through drill pipe with 20 sacks cement.
Hole filled to 25' with heavy mud.
Dumped 1/3 sack hulls, plug on top to 25'.
Cemented with 5 sacks cement.
Plugging completed at 12:00 noon.

RECEIVED
STATE CORPORATION COMMISSION

APR 24 1957

CONSERVATION DIVISION
Wichita, Kansas

(If additional description is necessary, use BACK of this sheet)
Name of Plugging Contractor A. L. Jackson Drilling Company
Address Box 194 Great Bend, Kansas

STATE OF Kansas, COUNTY OF Barton, ss.
W. L. Luther (employee of owner) or (owner or operator) of the above-described well, being first duly sworn on oath, says: That I have knowledge of the facts, statements, and matters herein contained and the log of the above-described well as filed and that the same are true and correct. So help me God.

(Signature) *W. L. Luther*
Box 194 Great Bend, Kansas
(Address)

SUBSCRIBED AND SWORN to before me this 17th day of April, 1957

Virgil E. McFarland
Notary Public.

My commission expires 4-27-57

PLUGGING
FILE SEC. 29 T. 21 R. 13W
BOOK PAGE 6 U E 44

Altman + Sylvan

WELL LOG
 Keller # 1
 300' West of NE SE SE
 29-21S-13W
 Stafford County, Kansas

		<u>Elevation</u>	<u>1908 D. F.</u>
0 - 185	Sand and clay		
185 - 300	Shale and sand		
300 - 308	Shale (Blue)		
308 - 670	Shale and Redbed		
670 - 775	Redbed		
775 - 805	Anhydrite		
805 - 1505	Shale and shells		
1505 - 1600	Shale, lime, streaks		
1600 - 1665	Shale and lime		
1665 - 1860	Lime		
1860 - 1990	Lime, shale streaks		
1990 - 2015	Lime		
2015 - 2440	Shale and lime		
2440 - 2700	Shale and lime streaks		
2700 - 2950	Shale and lime		
2950 - 3060	Lime		
3060 - 3175	Lime and shale streaks		
3175 - 3236	Lime		
3236 - 3241	Heebner		
3241 - 3280	Shale and lime - sandy		
3280 - 3392	Shale - lime streaks		
3392 - 3620	Lime		
3620 - 3665	Shale, lime and sandy lime		
3665 - 3700	Conglomerate		
3700 - 3758	Chert		
3758 - 3785	Lime and sand		
3785 - 3800	Lime and shale		
3800 - 3819	Shale, lime and sand		
3819 - 3833	Arbuckle		
3833	T. D.		

Formation Tops:

Heebner	3264
Brown Lime	3392
Lansing K. C.	3403
Marmation Lime	3646
Conglomerate	3664
Viola	3700
Arbuckle	3819

STATE OF KANSAS

COUNTY OF BARTON ss

Dick B. Evans, accountant for A. L. Jackson Drilling Company, being first duly sworn on oath says: That I have knowledge of the facts, statements and matters herein contained and the log of the above described well as filed and that the same are true and correct.

Dick B. Evans

Dick B. Evans

Subscribed and sworn before me this 19th day of April, 1957.

Virgil E. Belford, Jr.

Virgil E. Belford, Jr.
Notary Public Barton County

My Commission Expires: April 27, 1957

RECORDED
 STATE COMMISSION

APR 27 1957
 CONSERVATION DIVISION
 Wichita, Kansas

PLUGGING			
FILE	SEC. 29	T. 21	P. 13W
BOOK	PAGE. 6	L. 44	